

KANSAS

Rooks

FORM 51 IOM 12-46 PETROL

Section 25 / Township 10 Range 18-W

Well No. 1 Peatling "A"

Company Bridgeport et al

Burnett Pool

NORTH

0							

13

WEST

EAST

SOUTH

KANSAS Rooks



Sec. 25 Twp. 10 R. 18W

Well No. #1 Peatling "A" Farm

Bridgeport et al Company

Burnett


_____ Ft. from N. Line

330 Ft. from S. Line

_____ Ft. from E. Line

330 Ft. from W. Line

SW/C

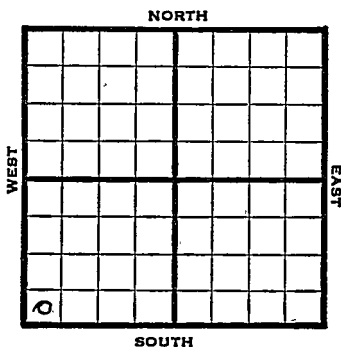

1947

Elev. 2049' REPORT

10/1

RUR

10/8

8" @ 158'
Drlg. 1650'

10/15

Drlg. 3190'

10/22

Lans. 3296'
Arbuckle 3655'
Total Depth 3705'

ABANDONED

Map No. _____ Sec. 25 Twp. 10 R. 18W

Well No. 1 Peatling "A"

Bridgeport etal. _____ Company

FIRST REPORT

Contractor

SW/C

SECTION PLAT

_____ Ft. from N. Line

330 Ft. from S. Line

_____ Ft. from E. Line

330 Ft. from W. Line

Rooks County

Location _____

Rig up _____

Drilling and Remarks:

R U R

RECORD

Cased _____ in., _____ ft.

Sand _____

Gas _____

Oil _____

Total Depth _____

PRODUCTION

1st 24 hrs. Nat. _____

1st 24 hrs. after shot _____

Gas _____ Cu. Ft.

Dry Hole _____

Abandoned _____

Date

OCT 1 1947 19

S. J. LEWIS Scout

Kansas Burnett Pool

Map No. 64 Sec. 25 Twp. 10 R. 18WWell No. 1 Peatling "A"Bridgeport etal. Company

ABANDONED

Contractor

SW/C

E12049
SECTION PLAT120 Ft. from N. Line330 Ft. from S. Line

_____ Ft. from E. Line

330 Ft. from W. Line

<u>0</u>			

Rooks County

Location _____

Rig up _____

Drilling and Remarks:

Lease 3296Oil 3605

RECORD

Cased _____ in., _____ ft.

Sand _____

Gas _____

Oil _____

Total Depth: 3705

PRODUCTION

1st 24 hrs. Nat. _____

1st 24 hrs. after shot _____

Gas _____ Cu. Ft.

Dry Hole _____

Abandoned _____

Date

OCT 22 1947 19S. J. LEWIS Scout