


Section 25 Township 10 Range 19 W

Well No. #1 Gasseway

Company Jones, Shelburne & Farmer

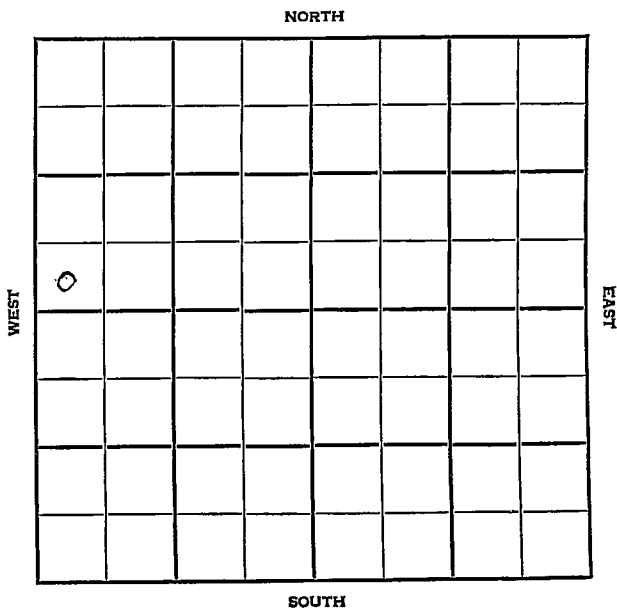

|            |            |           |
|------------|------------|-----------|
| SEC.<br>25 | TWP.<br>10 | R.<br>19W |
|------------|------------|-----------|

WELL NO.

#1 Gasseway

FARM

COMPANY

Jones, Shelburne &amp; Farmer

CONTRACTOR

Co. tools

|                        |       |       |  |  |  |  |      |
|------------------------|-------|-------|--|--|--|--|------|
| _____ Ft. from N. Line | WEST  | NORTH |  |  |  |  | EAST |
| _____ Ft. from S. Line |       |       |  |  |  |  |      |
| _____ Ft. from E. Line |       |       |  |  |  |  |      |
| _____ Ft. from W. Line |       |       |  |  |  |  |      |
| _____ Ft. from W. Line |       |       |  |  |  |  |      |
| SW SW NW               | SOUTH |       |  |  |  |  |      |

|      |           |        |
|------|-----------|--------|
| 1955 | ELEVATION | REPORT |
|      | 2097      |        |

9-14

MIR

9/28

Comm 9-14-55

8 5/8" @ 177/125

Anh 1400

Tp 3032

H 3248

Tr 3269

L 3288

BKG 3514

C 3543

S 3582

A 3620

TD 3645

DST 3433-56 open 1 hr Rec 5' mud

O# DST 3466-90 open 1 hr Rec 10' mud

625# TD 3645 D&amp;A

**ABANDONED**

County Rooks Elev. \_\_\_\_\_  
 Sec. 25 Twp. (10) Rgs. 19W  
 Company Jones, Shelburne & Farmer  
 FarmName Gasseway No. 1

| TOPS   | DEPTH | LOG | DATUM |
|--------|-------|-----|-------|
| Anh.   |       |     |       |
| Top    |       |     |       |
| H.     |       |     |       |
| Tr.    |       |     |       |
| Dg.    |       |     |       |
| Bl.    |       |     |       |
| L.     |       |     |       |
| K.C.   |       |     |       |
| B.K.C. |       |     |       |
| Ce.    |       |     |       |
| C.     |       |     |       |
| M.     |       |     |       |
| M.     |       |     |       |
| K.     |       |     |       |
| Mz.    |       |     |       |
| Mo.    |       |     |       |
| V.     |       |     |       |
| S.     |       |     |       |
| S.     |       |     |       |
| A.     |       |     |       |
| R.     |       |     |       |
| PE.    |       |     |       |
| G.     |       |     |       |
| T.D.   |       |     |       |

Loc. in Sec. SW SW NW


Geol. \_\_\_\_\_

Contr. Co. tools

Pool \_\_\_\_\_

|              |           |  |
|--------------|-----------|--|
|              |           |  |
|              | SEP 4 '55 |  |
| FIRST REPORT |           |  |

Date Comm. M I R

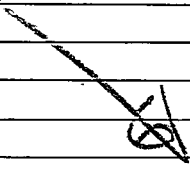

Co.  
Lse.  
No.  
Sec.  
T.  
R.

County Rooks Elev. 2097  
 Sec. 25 Twp. 10 Rge. 19W  
 Company Jones, Shelburne & Farmer  
 FarmName Gasseway No. 1

| TOPS   | DEPTH | LOG | DATUM | Loc. in Sec. |
|--------|-------|-----|-------|--------------|
| Anb.   | 1400  |     |       | SW SW NW     |
| Top.   | 3032  |     | 937   |              |
| H.     | 3248  |     | 1151  |              |
| Tr.    | 3269  |     | 1172  |              |
| Dg.    |       |     |       |              |
| Bl.    |       |     |       |              |
| L.     | 3288  |     | 1191  | Geol.        |
| K.C.   |       |     |       | Contr.       |
| B.K.C. | 3514  |     | 1417  |              |
| Ce.    |       |     |       | Co. tools    |
| C.     | 3543  |     | 1446  |              |
| M.     |       |     |       | Pool         |
| M.     |       |     |       |              |
| K.     |       |     |       |              |
| Mz.    |       |     |       |              |
| Ma.    |       |     |       |              |
| V.     |       |     |       |              |
| S.     | 3582  |     | 1485  |              |
| S.     |       |     |       |              |
| A      | 3620  |     | 1523  |              |
| R.     |       |     |       |              |
| Pe.    |       |     |       |              |
| G.     |       |     |       |              |
| TD.    | 3645  |     |       |              |

ABANDONED

Date Comm. 9-11-55 SEP 28 1955  
8 5/8" @ 177/125 DST 3433-56 open 1 hr  
Rec. 5' mud Off. DST 3466-90 open 1 hr  
Rec. 10' mud 625# TD 3645

D & A