

Section 25 Township 10 Range 20-WWell No. #1 Sutor "C"Company B & B Drlg.

NORTH

				0			

WEST

EAST

SOUTH

KANSAS

Rooks ✓

Sec. 25 Twp. 10 R. 20-W

Well No. #1 Sutor "C" Farm

B & B Drlg. Company

B & B Drlg. - Contr. Contractor


 Ft. from N. Line

330 Ft. from S. Line

 Ft. from E. Line

330 Ft. from W. Line

SW SW NE

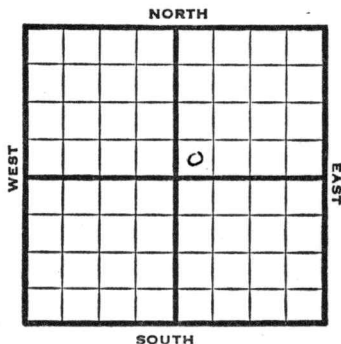

1950

Elev. 2151' REPORT

11/8

Location

12/6

Spud 11-10-50

D&A TD 3738

8" @ 173' Anhy 1595 Top 3174

Heeb 3385 Toronto 3406

Lans. 3425

DST 3448-66 opn 40 min Rec. 20' mud

DST 3500-08 opn 1 hr. Rec. 180'

fluid 60' socm & w 120' sw

Ch Cong. 3666 Arb. 3731-34

5" @ 3732 TD 3738

300 A S/5 bo 48 bw 12 hr.

D&A ABANDONED

County Rooks State KansasSec. 25 (Blk.) 10 (Sur.) 20W Map No.Operator B & B Drlg.Well No. 1 Farm Sutor "C"Elev. _____ Location SW SW NE

330 Ft. From S Line NE330 Ft. From W Line Quarter1st. Report NOV 8 1950

Completion _____


Remarks _____

Spudding Date _____

Drlg. Data _____

Location _____

J. E. TYRA

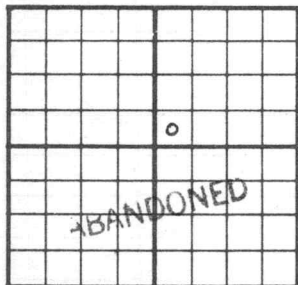County Rocks State KansasSec. 25 (Blk.
Twp.) 10 (Sur.
Rge.) 20W Map No. Operator B & B Drlg.Well No. 1 Farm Sutor "C"Elev. 2151 Location SW SW NE330 Ft. From S Line NE330 Ft. From W Line Quarter1st. ReportCompletion DEC 6 1950RemarksB & B Drlg. - Contr.Spudding Date 11-10-50Drlg. Data D & A TD 37388" @ 173 - Anhy 1595 Top. 3174Heeb. 3385 Toronto 3406 Lans. 3425DST 3448-66 open 40 min. Rec. 20' mudDST 3500-08 open 1 hr. Rec. 180' fluid60' socm & w 120' sw Ch. Cong. 3666Arb. 3731-34 5" @ 3732 TD 3738300 A S/ 5 bo 48 bw 12 hr.D & A