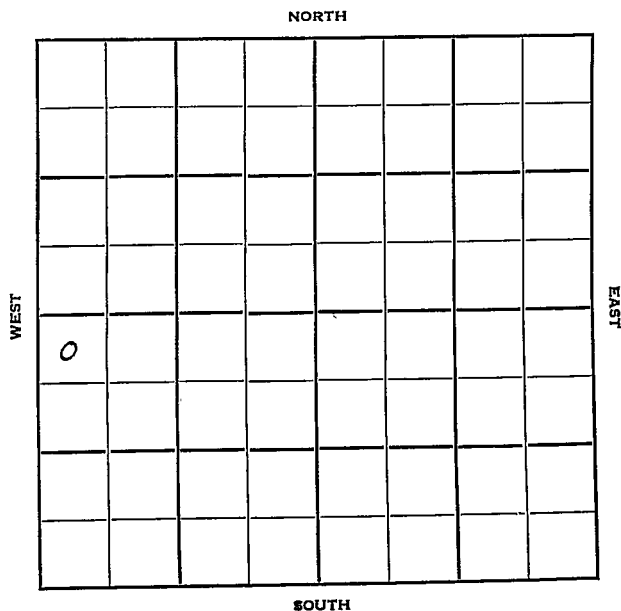


Section 25 Township 10 Range 20WWell No. #1 OuderkirkCompany Mid-States

Rooks

KANSAS

Sec. 25 Twp. 10 R. 20W

Well No. #1 Ouderkirk Farm

Mid-States Company

Harbar Drlg. Contractor

Berland Pool


330' Ft. from N. Line

 Ft. from S. Line

 Ft. from E. Line

330' Ft. from W. Line

NW NW SW

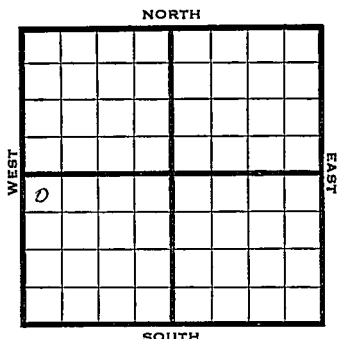

1950	Elev 2124	REPORT
3/22	Location	
7/19	Anhy 1550	
	8 5/8" @ 1561	
	Top 3146	Heeb 3365
	Toronto 3388	Lans 3403
	Simp 3685	Arb 3699
	TD 3713	
	5" @ 3700	
	S/1 boph	
	1000 acid	
	S/2 boph	
	3000 acie	
	S/4 boph	
	24/3700-08	
	S/77 bo 14 hr	
	3000 acid	
	S/ 30 bo	
	Pump 115 bbl fluid 95% wtr	
	Sq off	
	Pump 120 bbl fluid 6 hr 95% wtr	
	Sq off	
	24/3700-10	
	1000 acid	
	Pump 178 bo, 123 bwpd, Comp 33 bopd	
	81% wtr	
	Completed	
	COMPLETED	

Kansas

Berland Pool

Map No. _____ Sec. 25 Twp. 10 R. 2 OWWell No. 1 Ouderkirk

_____ Mid-States _____ Company

_____ Harbar Drlg. _____ Contractor


NW NW SW

SECTION PLAT

330 Ft. from N. Line

_____ Ft. from S. Line

_____ Ft. from E. Line

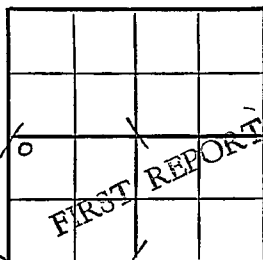330 Ft. from W. Line

Rooks County

Location X

Rig up _____

Drilling and Remarks:

RECORD

Cased _____ in., _____ ft.

Sand _____

Gas _____

Oil _____

Total Depth _____

PRODUCTION

1st 24 hrs. Nat. _____

1st 24 hrs. after shot _____

Gas _____ Cu. Ft.

Dry Hole _____

Abandoned _____

Date

MAR 22 1950 19

J. E. TYRA Scout

Kansas

Map No. _____ Sec. 25 Twp. 10 R. 20WWell No. 1 OuderkirkMid-States

Company


Contractor

NW NW SW

E1. 2124
SECTION PLAT330 Ft. from N. Line

Ft. from S. Line

Ft. from E. Line

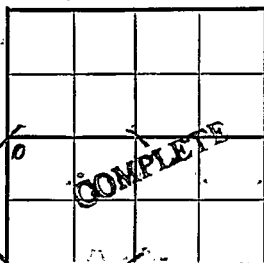330 Ft. from W. LineRooks County

Location _____

Rig up _____

Drilling and Remarks:

Anhy 1550

8 5/8" @ 1561

Top. 3146

Heeb. 3365

Toronto 3388

Lans. 3403

Simp. 3686

RECORD

Cased _____ in., _____ ft.

Sand _____

Gas _____

Oil _____

Total Depth 3713

PRODUCTION

1st 24 hrs. Nat. _____

1st 24 hrs. after shot _____

Gas _____ Cu. Ft.

Dry Hole _____

Abandoned _____

Date

JUL 19 1950

J. E. TYRA

Scout

Arb. 3699

TD 3713

5" @ 3700

S/ 1 boph

1000. acid

S/ 2 boph

3000. acid

S/ 4 boph

24/ 3700-08

S/ 77 bo 14 hr.

3000 acid

S/ 30 boph

Pump 115 bbl. fluid 95% water

Sq. off

Pump 120 bbl. fluid 6 hr. 95% water

Sq. off

24/ 3700-10

1000 acid

Pump 178 bbl. 123 bwpd

Comp. 33 bopd 81% water

Scout Cards
Land Small Map
Land Wall Map
Tracings
France Map
Pierce Map
Misc

1950

AUG