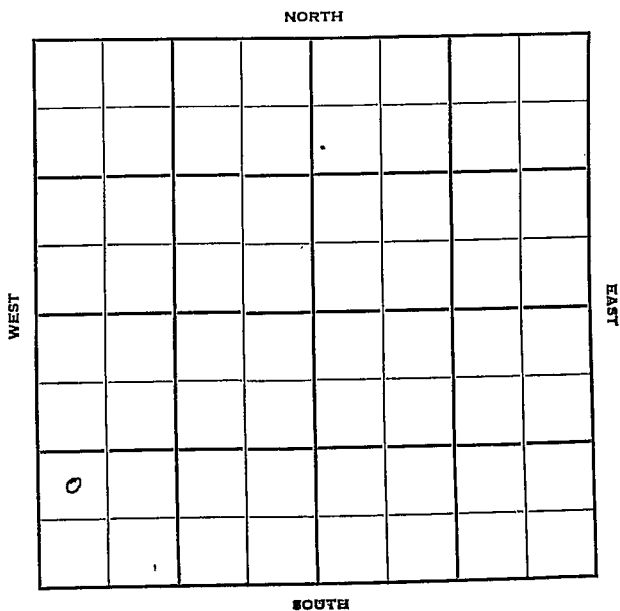


Section 25 Township 10 Range 20-WWell No. #1 OuderkirkCompany Mid-States

Rooks KANSAS

Sec. 25 Twp. 10 R. 20W

Well No. #4 Ouderkirk Farm

Mid-States Company

Harbar Drlg. & Contr. Contractor

SW Berland Pool

Ft. from N. Line

990'


Ft. from S. Line

Ft. from E. Line

330'

Ft. from W. Line

NW SW SW

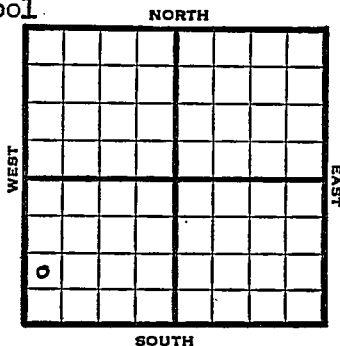

1950

Elev. 2167' REPORT

10/4

Spud 9-30-50
10-3/4" @ 298'
WOC

11/29

Spud 9-30-50
Oil Well TD 3755'
10-3/4" @ 298'
Top 3174' Heeb 3383'
Toronto 3405' Lans. 3420'
DST 3498-3506 opn 1/2 hr
Rec. 780' oil 120' ho & gcm
DST 3579-90 opn 40 min Rec. 20' socm
Cong. 3661' Simp 3703'
Arb. 3725' TD 3729
7 @ 3726 DD 3730 SSO
D 3732' S/2 BO 2 hr
DD 3735 S/8 boph 500 A S/9 boph
Comp. 339 bopd

COMPLETED

County Rooks State KansasSec. 25 (Blk. 10 (Sur. 20W (Twp. Map No.Operator Mid-StatesWell No. 4 Farm OuderkirkElev. Location NW SW SW

0							

990 Ft. From S Line SW330 Ft. From W Line Quarter1st. Report OCT 4 1950

Completion

Remarks

Harbar Drlg. - Contr.Spudding Date 9-30-50Drlg. Data SW Berland Pool10 3/4" @ 298 WOC

J. E. TYRA

County Rooks State Kansas

Sec. 25 (Blk. Twp.) 10 (Sur. Rge.) 20W Map No.

Operator Mid-States

Well No. 4 Farm Ouderkirk

Elev. 2167 Location NW SW SW

0

COMPLETE

990 Ft. From S Line SW

330 Ft. From W Line Quarter

1st. Report _____

Completion NOV 29 1950

Remarks SW Berland Pool

Harbar Drlg. - Contr.

Spudding Date 9-30-50

Drlg. Data Oil well TD 3735

10 3/4" © 298 Top. 3174 Heeb. 3383

Toronto 3405 Lans. 3420 DST 3498-3506

open $\frac{1}{2}$ hr. Rec. 780' oil 120' ho & gcm

DST 3579-90 open 40 min. Rec. 20' socm

Cong. 3661 ~~Simp.~~ 3703 Arb. 3725

TD 3729 7" @ 3726 DD 3730 SSO :

DD 3732 S/ 2 bo 2 hr. DD 3735 S/ 8 boph

500 A S/ 9 boph

Comp. 338 bond

E. TYRA