


Section 25 Township 10 Range 20W

Well No. #5 Onderkirk

Company Mid-States Oil

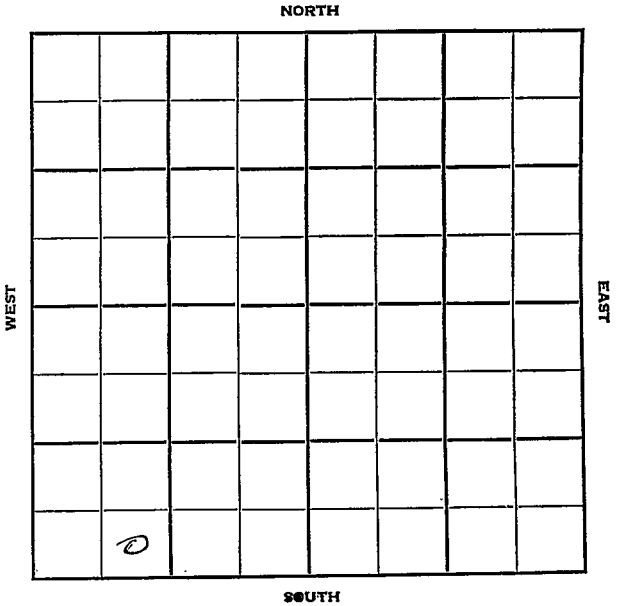

Rooks KANSAS

Sec. 25 Twp. 10 R. 20W ✓

Well No. #5 Ouderkirk Farm

Mid-States Oil Company

Harbar Drlg. - Contr. Contractor

Berland Pool


Ft. from N. Line

330' Ft. from S. Line

Ft. from E. Line

990' Ft. from W. Line

SE SW SW

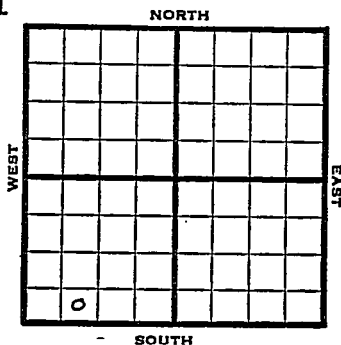

1950- Elev. 2146 REPORT

11/29 Spud 11-28-50

1951
1/3

Spud 11-28-50

D&A TD 3733

10" @ 301' Top 3163'

Heeb. 3376 Toronto 3398

Lans. 3413'

DST 3490-3500 opn 1 hr Rec. 680'

sw SSO Cong. 3661 Simp 3706

Arb. 3724-26 TD 7" @ 3724

DD 3729 500 A DD 3733


1 goph 20/3722 $\frac{1}{2}$ -27 $\frac{1}{2}$ 750 A

S/wtr & scum oil PB 3325

36/3418-24 45 gwph D&A

ABANDONED

J. E. TYRA

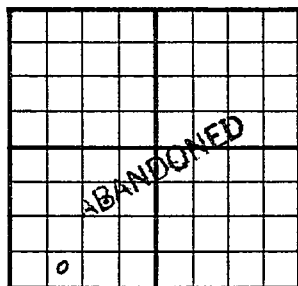County _____ Rooks _____ State KanSec. 25 (Blk. Twp.) 10 (Sur. Rge.) 20W Map No. _____Operator Mid-States OilWell No. 5 Farm OuderkirkElev. 2146 Location SE SW SW330 Ft. From S Line SW990 Ft. From W Line Quarter

1st. Report _____

Completion JAN 3 1951Remarks Berland PoolHarbar Drlg. - Contr.Spudding Date 11-28-50Drlg. Data D & A TD 373310" C 301 Top. 3163 Heeb. 3376Toronto 3398 Lans. 3413 DST 3490-3500open 1 hr. Rec. 680' sw SSOCong. 3661 Simp. 3706 Arb. 3724-26 TD7" C 3724 DD 3729 500 A DD 37331 goph 20/ 3722 $\frac{1}{2}$ -27 $\frac{1}{2}$ 750 AS/ water & scum oil PB 3325 36/ 3418-2445 gwph D & A