FORM 51


Graham

KANSAS

Section 25 Township 10 Range 21W

Well No. #4 Herrold

Company Anderson-Prichard

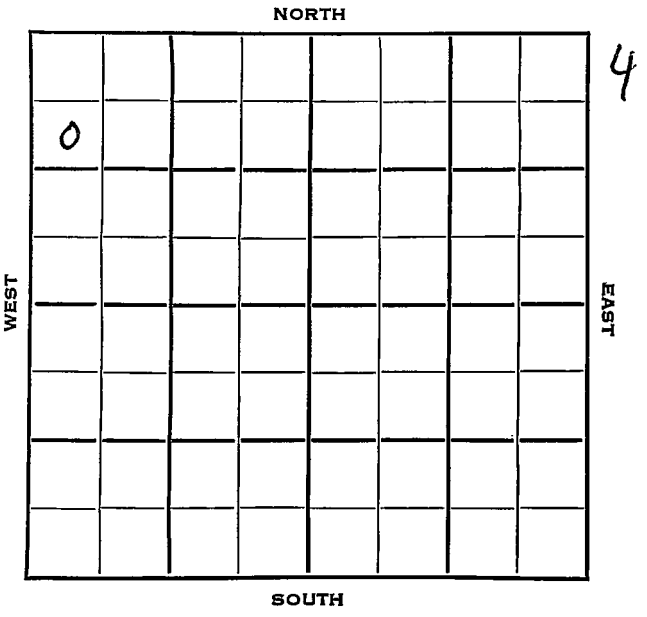

FORM 252-B
10M 10-50 PETROL

Graham

KANSAS

Sec. 25 Twp. 10 R. 21W

Well No. #4 Herrold Farm

Anderson-Prichard Company

Glenn Peel
White Pool Contractor


990 Ft. from N. Line

Ft. from S. Line

Ft. from E. Line

330 Ft. from W. Line

SW NW NW

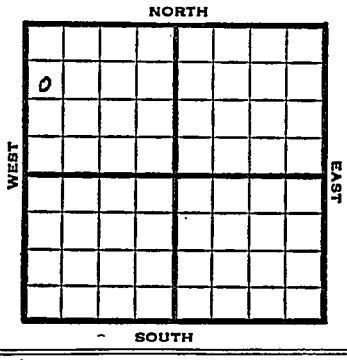

1953	Elev. 2149' REPORT
4/29	M I R
5/7	8" @ 220' Anhy 1615' Top 3176 Heeb 3380 Tor 3405' Lans 3423' Drlg. 3468'
5/21	Simp 3716' Arb. 3723'-3730' RTD DST 3723-30, 1/2 hr, 230' MCO 735# 5" @ 3724 CO 3730 S/8 BOPH 11 hrs. POP
5/28	N.R.
6/3	Spud 4-27-53 Oil Well TD 3730' 8" @ 220' Anhy 1615, Top 3176, Heeb 3380, Tor 3405, Lans 3423, Simp 3716, Arb 3723, TD 3730 DST 3723-30 opn ½ hr, rec 230' smco 735# 5" @ 3724' CO to 3730' S/ 8 boph 11 hr. Comp 83 bopd.

COMPLETED

FORM 275 FOR SALE BY KANSAS BLUE PRINT CO.


County Graham State Kansas

Sec. 25 (Blk. Twp.) 10 (Sur. Rge.) 21W Map No.

Operator Anderson-Prichard

Well No. 4 Farm Herrold

Elev. Location SW NW NW

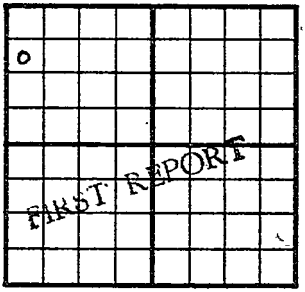

990Ft. From N Line NW

330Ft. From W Line Quarter

1st. Report APR 2 9 1953

Completion

Remarks Glenn Peel - Contr.

Spudding Date

Drlg. Data White Pool

M I R

J. G. McGEHEE

FORM 275 FOR SALE BY KANSAS BLUE PRINT CO.


County Graham State Kansas

Sec. 25 (Blk. Twp.) 10 (Sur. Rge.) 21W Map No.

Operator Anderson-Prichard

Well No. 4 Farm Herrold

Elev. 2149 Location SW NW NW

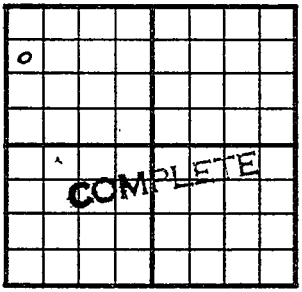

990 Ft. From N Line NW

330 Ft. From W Line Quarter

1st. Report

Completion JUN 3 1953

Remarks White Pool

Glenn Peel - Contr.

Spudding Date 4-27-53

Drlg. Data Oil well TD 3730

8" @ 220 Anhy 1615 Top. 3176

Heeb. 3380 Tor. 3405 Lans. 3423

Simp. 3716 Arb. 3723 TD 3730

DST 3723-30 open ½ hr. Rec. 230' smco

735# 5" @ 3724 CO to 3730

S/ 8 boph 11 hr. Comp. 83 bopd

J. G. McGEHEE