

Sec. 25 Twp. 10 R. 21W

Well No. #5 Herrold Farm

Anderson-Prichard Company

Glenn Peel Contractor

White Pool


330 Ft. from N. Line

_____ Ft. from S. Line

_____ Ft. from E. Line

330 Ft. from W. Line

NW NW NW

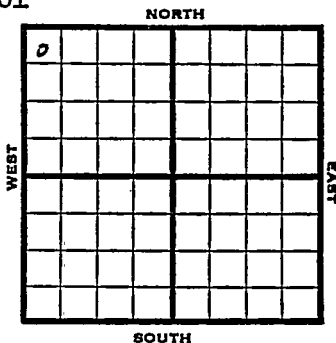

1953 Elev. 2144' REPORT

6/3 Loc.

6/10 8" @ 205'
Anhy 1615'
Drlg 3163'

6/24 No report

7/22 Spud 6-2-53
Oil well TD 3750 8" @ 205
Anhy 1615 Top 3180' Heeb 3383'
Tor. 3410 Lans 3426
DST 3711-48 open 1 hr rec 130' HO &
GCM 825# Arb. 3740 TD 3750
5" @ 3744 CO to 3750 55 A
S/1½ BOPH 12 hr. 250 A S/1½ BOPH
12 hr. SSW P/14 BO 10 hr.
P/4 BO 1% wtr. 6 hr. 500 A
Comp. 27 BOPD ¼ BW

COMPLETED

County Graham State KANSAS

Sec. 25 (Blk. Twp.) 10 (Sur. Rge.) 21W Map No.

Operator Anderson-Prichard

Well No. 5 Farm Herrold

Elev. _____ Location NW NW NW

o							
FIRST REPORT							

330 Ft. From N Line NW

330 Ft. From W Line Quarter

1st. Report JUN 3 1953

Completion _____

Remarks Glenn Peel - Contr.

Spudding Date _____

Drlg. Data WhitePool

Location

County Graham State KansasSec. 25 (Blk. Twp.) 10 (Sur. Rge.) 21W Map No.Operator Anderson-PrichardWell No. 5 Farm HerroldElev. 2144 Location NW NW NW

6					

330 Ft. From N Line NW330 Ft. From W Line Quarter

1st. Report

Completion JUL 22 1953Remarks White PoolGlenn Peel - Contr.Spudding Date 6-2-53Drlg. Data Oil well TD 37508" @ 205 Anhy 1615 Top. 3180Heeb. 3383 Tor. 3410 Lans. 3426DST 3711-48 open 1 hr. Rec. 130' ho &gcm 825# Arb. 3740 TD 3750 5" @ 374CO to 3750 55 A S/ 1½ boph 12 hr.250 A S/ 1½ boph 12 hr. SSW E/ 14 bo10 hr. P/ 4 bo 1% wtr. 6 hr. 500 AComp. 27 bopd. ¼ bw