

Section 25 Township 10 Range 21W

Well No. #2 #1 White

Company Petroleum Inc.

NORTH

12

WEST

EAST

0							

SOUTH

Graham

KANSAS

Sec. 25 Twp. 10 R. 21W

Well No. #2 ~~#1~~ White Farm

Petroleum Inc. Company

Wildcat Contractor


330 Ft. from N. Line

_____ Ft. from S. Line

_____ Ft. from E. Line

330 Ft. from W. Line

NW NW SW

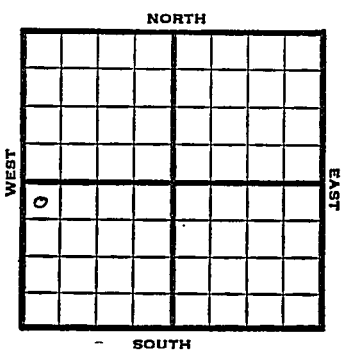

Stanolind-Support

1952 Elev. 2124' REPORT

3/26 Spud 3-20-52
8" @ 187'
Drlg. 2245'

4/1 Heeb. 3367 Tor. 3393
Lans. 3408
DST 3435-80, 1 hr. 95' muddy wtr.
1090#
DST 3489-3514, 1 hr. 80' wtry m.
1100#
DST 3572-3610, 40 mins. 5' m
0#
DST 3716-19, 40 mins. 15' oil
10' m 920#
Arb. 3715 RTD 3719
5" @ 3716'

4/9 Heeb. 3378 Tor. 3402
Lans. 3412
Drlg. 3716'

4/23 DD 3721' 1 1/2 BOPH for 10 hrs.
250 A S/2 to 3 BOPH for 24 hrs.
POP

4/30 NR
5/7 "

OVER

1952

5/13

Spud 3-20-52

Oil Well

TD 3721

8" @ 187 Heeb. 3367 Tor. 3393

Lans. 3408

DST 3435-80 opn 1 hr.

Rec. 95' muddy wtr DST 3489-3514

opn 1 hr. Rec. 80' watery mud.

DST 3572-3610 opn 40 min. Rec. 5' mud

Arb. 3715 TD 3719

DST 3716-19 opn 40 min. Rec. 15'

oil 10' mud

5" @ 3716 TD 3721 $1\frac{1}{4}$ boph 10 hr.

250 A 2 to 3 boph Comp. 154 bopd

COMPLETED

County Graham State Kansas

Sec. 25 (Blk. Twp.) 10 (Sur. Rge.) 21W Map No.

Operator Petroleum Inc.

Well No. 1 Farm White

Elev. all correction Location NW NW SW

330 Ft. From N Line SW

330 Ft. From W Line Quarter

Ist. Report MAR 26 1952

Completion _____

Remarks Stanolind-support

Spudding Date 3-20-52

Drig. Data Wildcat

8" @ 187 Drig. 2245

FIRST REPORT

Kansas

Map No. _____ Sec. 25 Twp. 10 R. 21W

Well No. 2 White

_____ Petroleum Inc. _____ Company

CORRECTION

_____ Contractor

NW NW SW

SECTION PLAT

330 Ft. from N. Line

_____ Ft. from S. Line

_____ Ft. from E. Line

330 Ft. from W. Line

0			

Graham County

Location _____

Rig up _____

Drilling and Remarks:

Reported

#1 White

RECORD

Cased _____ in., _____ ft.

Sand _____

Gas _____

Oil _____

Total Depth _____

PRODUCTION

1st 24 hrs. Nat. _____

1st 24 hrs. after shot _____

Gas _____ Cu. Ft.

Dry Hole _____

Abandoned _____

Date

APR 2 1952 19

J. G. McGEHEE Scout

