15-10-25W


FORM CP-4

STATE OF KANSAS
STATE CORPORATION COMMISSION

State Geological Survey
WICHITA BRANCH

WELL PLUGGING RECORD

Give All Information Completely
Make Required Affidavit
Mail or Deliver Report to
Conservation Division
State Corporation Comm.
245 North Water
Wichita, KS 67202

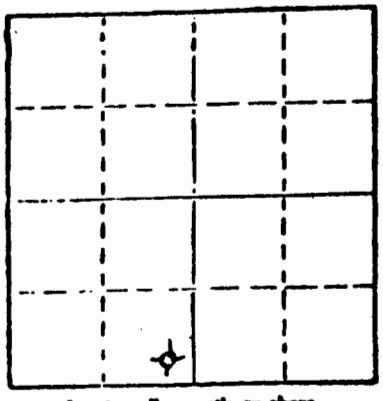

Locate well correctly on above Section Plat

Graham County. Sec. 15 Twp. 10S Rge. 25 X~~E~~/W

Location as "NE/CNW¼SW¼" or footage from lines SE SE SW

Lease Owner Helberg Oil Company

Lease Name Dinkel Well No. #1

Office Address Box 32 Morland, Kansas 67650

Character of Well (Completed as Oil, Gas or Dry Hole) Dry Hole

Date Well completed 9-22 19 81

Application for plugging filed 9-22 19 81

Application for plugging approved 9-22 19 81

Plugging commenced 9-22 19 81

Plugging completed 9-22 19 81

Reason for abandonment of well or producing formation Dry Hole

If a producing well is abandoned, date of last production 19__

Was permission obtained from the Conservation Division or its agents before plugging was commenced? Yes

Name of Conservation Agent who supervised plugging of this well Gilbert Balthasor

Producing formation _____ Depth to top ____ Bottom ____ Total Depth of Well 40~~7~~'

Show depth and thickness of all water, oil and gas formations.

OIL, GAS OR WATER RECORDS — CASING RECORD

FORMATION	CONTENT	FROM	TO	SIZE	PUT IN	PULLED OUT
Surface		0	209'	8 5/8"	209'	0

cribe in detail the manner in which the well was plugged, indicating where the mud fluid was placed and the method or methods used in introducing it into the hold. If cement or other plugs were used, state the character of same and depth placed, from _____ feet to _____ feet for each plug set.

1st. Plug set at 1150' with 60 sacks common cement 50-50poz 6% Gel

2nd. Plug set at 200' with 40 sacks common cement 50-50 poz 6% Gel

3rd. Plug set at 40' with 10 sacks common cement 50-50poz 6% Gel

5 sacks in rathole

Circulated mud at 1190'

(If additional description is necessary, use BACK of this sheet)

Name of Plugging Contractor Sun Oilwell Cementing

STATE OF Kansas COUNTY OF Graham, ss.

Jerry M. Helberg (employee of owner) or (owner or operator) of the above-described well, being first duly sworn on oath, says: That I have knowledge of the facts, statements, and matters herein contained and the log of the above-described well as filed and that the same are true and correct. So help me God.