

STATE CORPORATION COMMISSION OF KANSAS
OIL & GAS CONSERVATION DIVISIONWELL COMPLETION OR RECOMPLETION FORM
ACO-1 WELL HISTORY

DESCRIPTION OF WELL AND LEASE

Operator: license # 5205
name Mid-Continent Energy Corporation
address 120 S. Market, Suite 712
City/State/Zip Wichita, KS 67202

Operator Contact Person Larry P. Schneider
Phone (316) 265-9501

Factor: license # 5815
name C & R Drilling Company

Wellsite Geologist Macklin Armstrong
Phone (316) 722-5141

Designate Type of Completion

☒ New Well ☐ Re-Entry ☐ Workover

☐ Oil ☐ SWD ☐ Temp Abd
☐ Gas ☐ Inj ☐ Delayed Comp.
☒ Dry ☐ Other (Core, Water Supply etc.)

If WO: old well info as follows:

Operator
Well Name
Comp. Date Old Total Depth

WELL HISTORY

Drilling Method: ☒ Mud Rotary ☐ Air Rotary ☐ Cable

8/2/84 8/23/84 8/23/84
Spud Date Date Reached TD Completion Date
4,045' N/A
Total Depth PBDT

Amount of Surface Pipe Set and Cemented at 226' feet

Multiple Stage Cementing Collar Used? ☐ Yes ☒ No

If Yes, Show Depth Set feet

If alternate 2 completion, cement circulated
from feet depth to w/ SX cmt

API NO. 15 - 065-22,044

County Graham
100' W of
NE 1/4 NW 1/4 SW 1/4 Sec 31 Twp. 10S. Rge. 25 West

2310 Ft North from Southeast Corner of Section
4290 Ft West from Southeast Corner of Section
(Note: locate well in section plat below)


Lease Name Mader Well# 1

Field Name Wildcat

Producing Formation N/A

Elevation: Ground 2,477' KB 2,482'

Section Plat

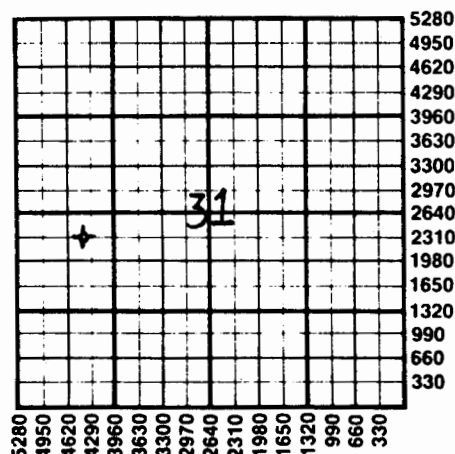

WATER SUPPLY INFORMATION

Source of Water: Landowner's Irrigation Well

Division of Water Resources Permit #

☐ Groundwater Ft North From Southeast Corner and
(Well) Ft. West From Southeast Corner of
Sec Twp Rge ☐ East ☐ West

☐ Surface Water Ft North From Southeast Corner and
(Stream, Pond etc.) Ft West From Southeast Corner
Sec Twp Rge ☐ East ☐ West

☐ Other (explain)
(purchased from city, R.W.D.#)

Disposition of Produced Water: ☐ Disposal
☐ Repressuring

Docket #

INSTRUCTIONS: This form shall be completed in duplicate and filed with the Kansas Corporation Commission, 200 Colorado Derby Building, Wichita, Kansas 67202, within 90 days after completion or recompletion of any well. Rules 82-3-130 and 82-3-107 apply.

Information on side two of this form will be held confidential for a period of 12 months if requested in writing and submitted with the form. See rule 82-3-107 or confidentiality in excess of 12 months.

One copy of all wireline logs and drillers time log shall be attached with this form. Submit CP-4 form with all plugged wells. Submit CP-111 form with all temporarily abandoned wells.

CONSERVATION DIVISION
Wichita, Kansas

If requirements of the statutes, rules, and regulations promulgated to regulate the oil and gas industry have been fully complied with and the statements herein are complete and correct to the best of my knowledge.

Signature Larry P. Schneider
Title Exploration Manager Date 9/6/84

Subscribed and sworn to before me this 6th day of September, 1984.

Notary Public
My Commission Expires



State Geological Survey
WICHITA BRANCH

K.C.C. OFFICE USE ONLY

F ☐ Letter of Confidentiality Attached
C ☒ Wireline Log Received
C ☐ Drillers Timelog Received

Distribution

☒ KCC ☐ SWD/Rep ☐ NGPA
☒ KGS ☐ Plug ☐ Other
(Specify)

Form ACO-1
(This form supercedes
previous forms
ACO-1 & C-10)

Sec. 31, Twp. 10, Rge. 25

☐ East
☒ West

INSTRUCTIONS: Show important tops and base of formations penetrated. Detail all cores. Report all drill stem tests giving interval tested, time tool open and closed, flowing and shut-in pressures, whether shut-in pressure reached static level, hydrostatic pressures, bottom hole temperature, fluid recovery, and flow rates if gas to surface during test. Attach extra sheet if more space is needed. Attach copy of log.

Name	Top	Bottom
Anhydrite	2,111'	+ 371'
Base Anhydrite	2,150'	+ '
Topeka	3,534'	-1,052'
Heebner	3,750'	-1,268'
Lansing	3,793'	-1,311'
Base Kansas City	4,020'	-1,538'
L.T.D.	4,043'	-1, '
R.T.D.	4,045'	-1,563'


[illegible]