Graham KANSAS


26 10S 23W

SECTION TOWNSHIP RANGE

WELL NO. #1 Klenk

COMPANY Davis Bros. & Transit Corp.

SE SE NE

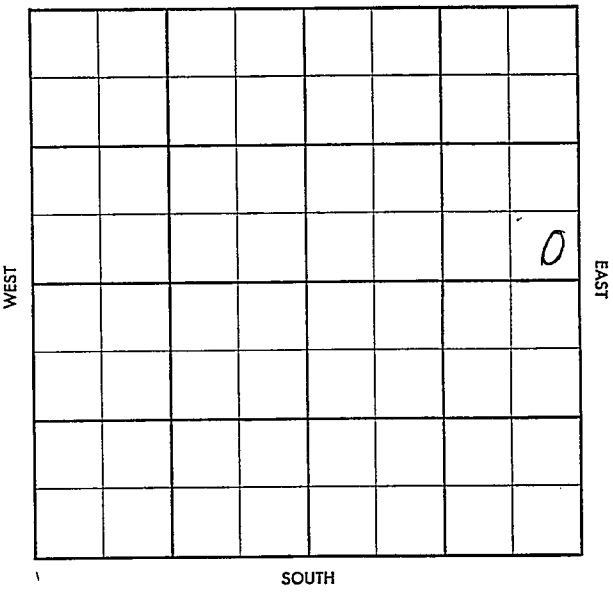

FORM 504-3 SUNRAY

WILDCAT

FORM 513 SUNRAY

County Graham Elev. 2345' DF

Sec. 26 Twp. 10S Rge. 23W

Company Davis Bros. & Transit Corp.

Farm Name Klenk No. 1


TOPS	DEPTH	LOG	DATUM
Anh.	1865		
T.P.			
H.	3581		
Tr.	3600		
Dg.			
Bl.			
L.	3617		
K.C.			
B.K.C.			
Ce.			
C.			
M.			
M.			
K.			
Mz.			
Mo.			
V.			
S.			
S.			
A			
R.			
P€.			
G.			
T.D.			

Loc. in Sec. SE SE NE

Geol.

Contr. Transit Tools

Pool Wildcat

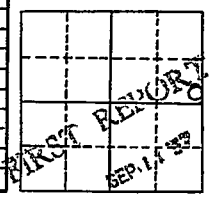

Date Comm. 8-29-57

7" @ 184, DST 3621-40 ½ hr. 1018' sw, BHP 885/20 DST 3641-3701, 3/4 hr. rec. 20' sli ocm, BHP 540/15, DST 3690-3770, op 1 hr. rec. 728' sw BHP 1060/20, DST 3766-3860, 1½ hr, rec. 90' ocm, BHP 165/15, RTD 3887, 5" @ 3887 WOC

Co. Lse. No. Sec. T. R.

FORM 513 SUNRAY

County Graham Elev. 2345 DF

Sec. 26 Twp. 10S Rge. 23W

Company Davis Bros. & Transit Corp.

Farm Name Klenk No. 1

TOPS	DEPTH	LOG	DATUM
Anh.	1865		
Tp.			
H.	3581		
Tr.	3600		
Dg.			
Bl.			
L.	3617		
K.C.			
B.K.C.			
Ce.			
C.			
M.			
M.			
K.			
Mz.			
Mo.			
V.			
S.			
S.			
A			
R.			
Pe.			
G.			
T.D.			

Loc. in Sec. SE SE NE

Geol.

Contr. Transit Tool

Pool Wildcat

ABANDONED

e

SEP 18 '57

Date Comm. 8-29-57

8" @ 184, DST 3621-40 ½ hr. 1018' sw, BHP 885/20 DST 3641-3701, 3/4 hr. rec. 20' sli ocm, BHP 540/15, DST 3690-3770, op 1 hr. rec. 728' sw BHP 1060/20, DST 3766-3860, 1½ hr, rec. 90' ocm, BHP 165/15, RTD 3887, 5" @ 3887 WOC SEP 18 57 56/3784-3808

1500A NDS 32/3774-82

1500A no shows 24/3692-98

4 BWDH 32/3671-79

Co. Lse. No. Sec. T. R.

FORM 513-1 SUNRAY

8/3663-65 500A

D+A

26-10-23W se se ne