


Section 26 Township 10 Range 18^W

Well No. #1 Weiner

Company M & L Oil

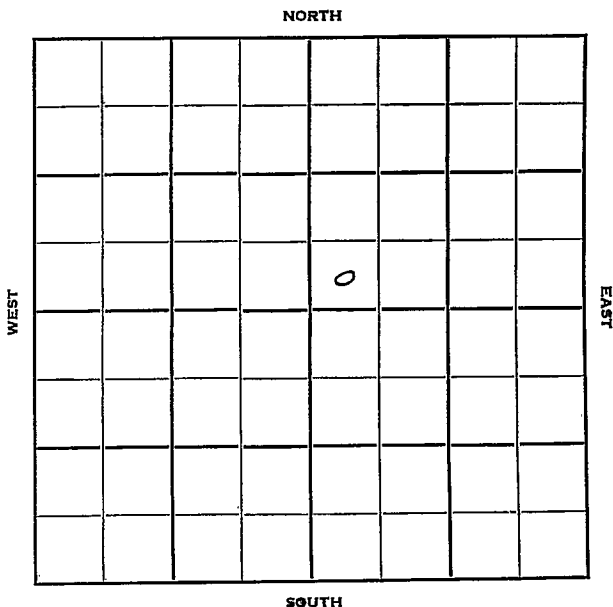

Rooks KANSAS

Sec. 26 Twp. 10 R. 18 W

Well No. # 1 Weiner Farm

M & L Oil Company

C & G Drlg. Contractor

Wildcat


Ft. from N. Line

330 Ft. from S. Line

Ft. from E. Line

330 Ft. from W. Line

SW SW NE

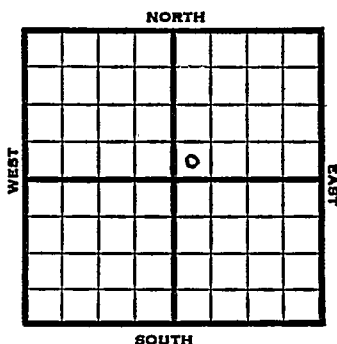

1951

Elev. 2108' REPORT

3/21

Location

4/4

Spud 3-20-51

D & A TD 3715'

8" @ 220 Anhy 1455' Top 3075'


Heeb 3322' Toronto 3341' Lans 3365'

DST 3519-27' open 40 min. Rec. 20' mud

Cong 3663' TD 3715' D & A

ABANDONED

County Rooks State Kansas
 Sec. 26 (Blk.) 10 (Sur.) 18W Map No.
 (Twp.) (Rge.)
 Operator M & L Oil
 Well No. 1 Farm Weiner
 Elev. Location SW SW NE

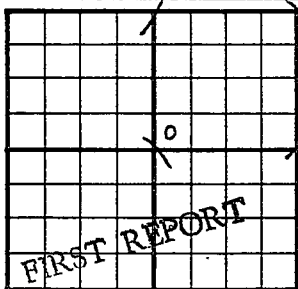

330 Ft. From S Line NE
330 Ft. From W Line Quarter
 Ist. Report MAR 21 1951

Completion

Remarks

C & G Drlg. - Contr.


Spudding Date

Drlg. Data

Wildcat

Location

J. E. TYRA

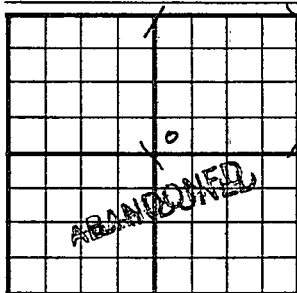County _____ Rooks _____ State KansasSec. 26 (Blk. 10 (Sur. 18W Map No. _____
(Twp.) (Rge.)Operator M & L OilWell No. 1 Farm WeinerElev. 2108 Location SW SW NE330 Ft. From S Line NE330 Ft. From W Line Quarter

1st. Report _____

Completion APR 4 1951Remarks WildcatC & G drlg. - Contr.Spudding Date 3-20-51Drlg. Data D & A TD 37158" @ 220 Anhy 1455 Top. 3075Heeb. 3322 Toronto 3341 Lans. 3365DST 3519-27 open 40 min. Rec. 20' mudCong. 3663 TD 3715D & A