

KANSAS

Rooks

FORM 51 IOM 12-46 PETROL

Section 26 Township 10 Range 19-W

Well No. 1 Smith

Company A. D. Allison

Zurich Pool

NORTH

WEST

EAST

SOUTH

Rooks

✓
X

Sec. 26 Twp. 10 R. 19W

KANSAS

Well No. 1 Smith Farm

A. D. Allison Company


Zurich Pool

 Ft. from N. Line

990 Ft. from S. Line

 Ft. from E. Line

990 Ft. from W. Line

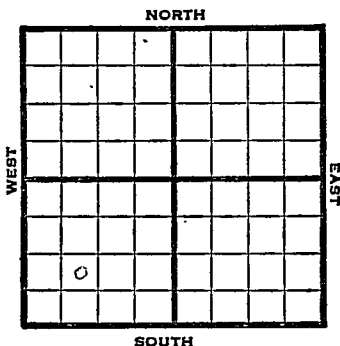

NE SW-SW

194 7 Elev. 2103 REPORT

8/13 8" @ 175
anhy 1403
Drlg. 1900'

8/20 Lansing 3315
Drlg. 3370'

8/27 BKC 3549'
Arbuckle 3660'
TD 3694'
5" @ 8566
RUST

9/3 "

9/10 47 shots 3510-16
SO & W
Perf?
Shots. 3082-92

9/17 "

9/24 "

10/1 Perf 3660
5" @ 3566
Perf Topeka & Lansing
TD 3194

ABANDONED

Map No. _____ Sec. 26 Twp. 10 R. 19W

Well No. 1 Smith

A. D. Allison Company

FIRST REPORT Contractor

NE SW SW

SECTION PLAT

_____ Ft. from N. Line

990 Ft. from S. Line

_____ Ft. from E. Line

990 Ft. from W. Line

o			

Rooks County

Location _____

Rig up _____

Drilling and Remarks:

8" @ 175

anhy 1403

drlg. 1900

RECORD

Cased _____ in., _____ ft.

Sand _____

Gas _____

Oil _____

Total Depth _____

PRODUCTION

1st 24 hrs. Nat. _____

1st 24 hrs. after shot _____

Gas _____ Cu. Ft.

Dry Hole _____

Abandoned _____

Date

AUG 13 1947 19

S. J. LEWIS Scout

