

26 Rooks

KANSAS

Sec. 35 Twp. 10 R. 19 W ✓

Well No. # 1 Johnson Farm

Veeder Supply Company


Contractor

Ft. from N. Line

330 Ft. from S. Line

Ft. from E. Line

990 Ft. from W. Line

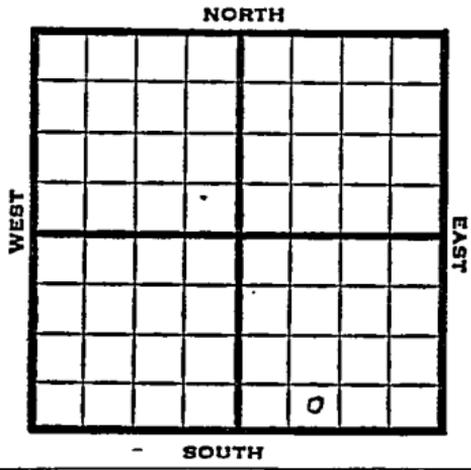

SE SW SE
Sohio Farmout.

1951

Elev. 2076' REPORT

9/19 8" @ 217' Drilling

10/3

D&A TD 3660
 8" @ 217
 Top. 3009 Heeb. 3254
 Tor. 3277 Lans. 3296
 DST 3320-50 opn 1 hr.
 Rec. 187' sw & mud
 DST 3457-3512 opn 1hr. Rec. 47'
 socm
 Cong. 3552 Simp 3560
 ReArb. 3613 Arb. 3653
 TD 3660
 D&A

ABANDONED

