

Section 26 Township 10 Range 20 W

Well No. # 1 Annon

Company Strain Drlg. & Brooks Hall

NORTH

	0						

WEST

EAST

SOUTH

Rooks
10

KANSAS
20W

Sec. 26 Twp. _____ R. _____

Well No. #1 Annon Farm _____

StrainDrlg. & Brooks Hall Company _____

Wildcat Contractor _____


_____ Ft. from N. Line

330 Ft. from S. Line

_____ Ft. from E. Line

330 Ft. from W. Line

SW SW NW
Sunray & Derby - DHM

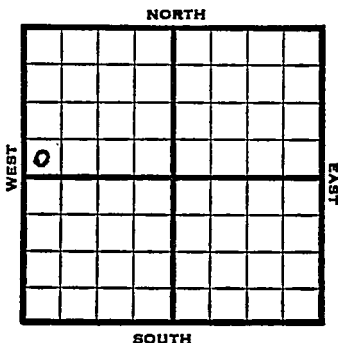

1953 Elev. 2175' REPORT

5/20 Spud 5-17-53
Setting Surface

5/27 Spud 5-17-53
D & A
TD 3800'
8" @ 166'
Anhy 1620, Heeb 3417, Lans 3455, B KC
3650, Cong 3720, Arb 3775
TD 3800
D & A

ABANDONED

County _____ Rooks _____ State **Kansas**

Sec. 26 (Blk. Twp.) 10 (Sur. Rge.) 20W Map No.

Operator **Strain Drlg. & Brooks Hall**

Well No. 1 Farm Annon

Elev. 2175 Location SW SW NW

o					
ABANDONED					

330 Ft. From S Line NW

330 Ft. From W Line Quarter

Ist. Report _____

Completion **MAY 27 1953**

Remarks **Wildcat**

Spudding Date **5-17-53**

Drlg. Data D & A TD 3800

8" @ 166 Anhy 1620 Heeb. 3417

Lans. 3455 B KC 3650 Cong. 3720

Arb. 3775 TD 3800

D & A