FORM 51 25M 8-50 WESTERN


Rooks

KANSAS

Section 26 Township 10 Range 20W

Well No. #1 M. Annon

Company Champlin Ref.

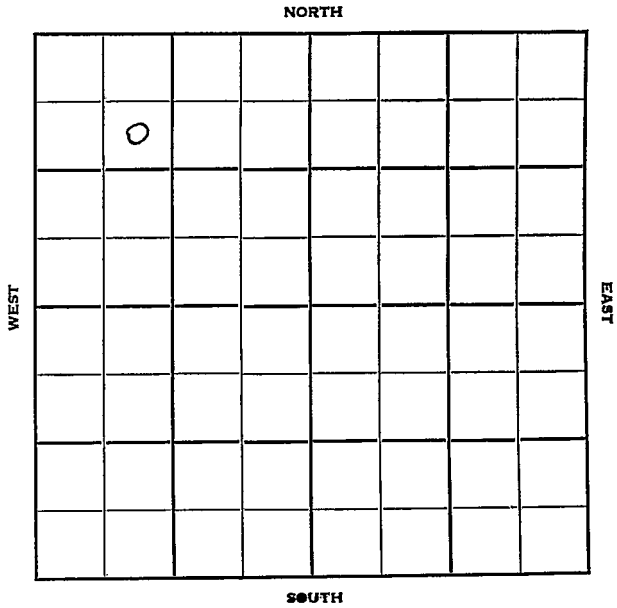

FORM 252-B
10M 8-51 TPCO.

KANSAS

Rooks

Sec. 26 Twp. 10 R. 20W

Well No. #1 M. Annon Farm

Champlin Ref. Company

Contractor

Berland Pool


990' Ft. from N. Line

Ft. from S. Line

Ft. from E. Line

990' Ft. from W. Line

SE NW NW

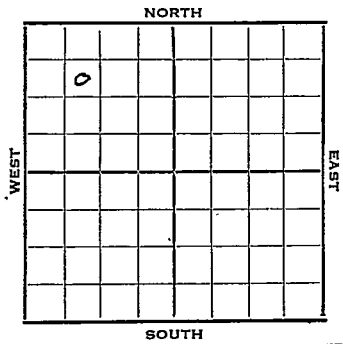

1951	Elev. 2194' REPORT
11/28	RUR
12/12	Spud 11-29-51 D&A TD 3870 8" @ 144 Heeb. 3439 KC 3478 Cong. 3724 ReArb. 3831 Arb. 3855-70 TD D&A

ABANDONED

FORM 275 FOR SALE BY KANSAS BLUE PRINT CO.


County Rooks State Kansas

Sec. 26 (Blk. Twp.) 10 (Sur. Rge.) 20W Map No.

Operator Champlin Ref.

Well No. 1 Farm M. Annon

Elev. Location SE NW NW

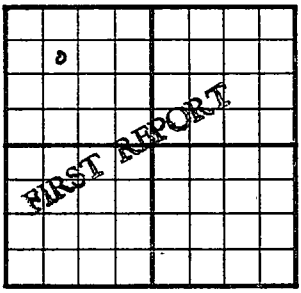

990 Ft. From N Line NW

990 Ft. From W Line Quarter

1st. Report NOV 28 1951

Completion

Remarks

Spudding Date

Drlg. Data Berland Pool

R U R

J. E. TYRA

FORM 275 FOR SALE BY KANSAS BLUE PRINT CO.


County Rooks State Kansas

Sec. 26 (Blk. Twp.) 10 (Sur. Rge.) 20W Map No.

Operator Champlin Ref.

Well No. 1 Farm M. Annon

Elev. 2194 Location SE NW NW

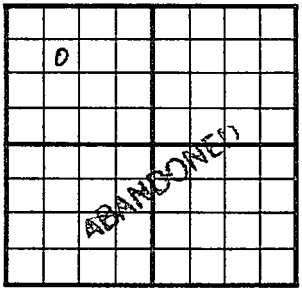

990 Ft. From N Line NW

990 Ft. From W Line Quarter

1st. Report

Completion DEC 1 2 1951

Remarks Berland Pool

Spudding Date 11-29-51

Drlg. Data D & A TD 3870

8" @ 144 Heeb. 3439 KC 3478

Cong. 3724 ReArb. 3831 Arb. 3855-70 TD

D & A

J. E. TYRA