
Rooks KANSAS

SECTION 26 TOWNSHIP 10 RANGE 20W

WELL NO. #2 Armbruster "B"

COMPANY ElDorado Refg.

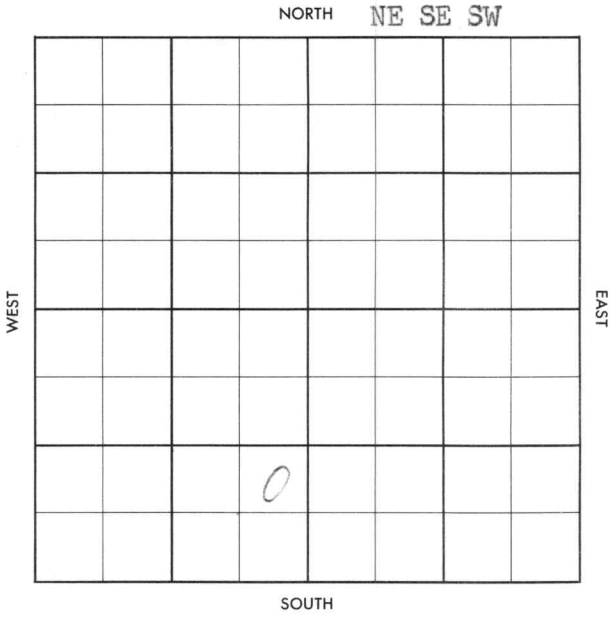

FORM 504-3 SUNRAY

FORM 513 SUNRAY

County Rooks Elev. 2211 DF

Sec. 26 Twp. 10 Rge. 20W

Company El Dorado Refg.

Farm Name Armbruster "B" No. 2

TOPS	DEPTH	LOG	DATUM
Anh.			
T.P.			
H.			
Tr.			
Dg.			
B.L.			
L.			
K.C.			
B.K.C.			
Ce.			
C.			
M.			
M.			
K.			
Mz.			
Mo.			
V.			
S.			
S.			
A			
R.			
P€.			
G.			
T.D.			

Loc. in Sec. NE SE SW

Geol.

Contr. Sierra Drlg.

Pool Marcotte

JUN 26 '57

FIRST REPORT

Date Comm. 6-19-57

8" @ 243/135, Drlg. 3106

Co. Lse. No. Sec. T. R.

FORM 513 SUNRAY

County Rooks Elev. 2211 DF

Sec. 26 Twp. 10 Rge. 20W

Company ElDorado Refg.

Farm Name Armbruster "B" No. 2

TOPS	DEPTH	LOG	DATUM
Anh.			
Tp.			
H.	3440		
Tr.			
Dg.			
Bl.			
L.	3476		
K.C.			
B.K.C.	3687		
Ce.			
C.	3720		
M.			
M.			
K.			
Mz.			
Mg.			
V.			
S.	3759		
S.			
A	3771		
R.			
P€.			
G.			
T.D.	3775		

Loc. in Sec. NE SE SW

Geol.

Contr. Sierra Drlg.

Pool Marcotte

AUG 21 '57

COMPLETE

Date Comm. 6-19-57

8" @ 243/135, Drlg. 3106 JUL 3 '57 DST 3500-25 1hr 900' Gip rec 730' oil + 30' OCM 140-340 BHP 1260/20" DST 3535-65 1hr 570' Gip rec 120' OCM + 150' VHOCM + 120' cl. oil BHP 1120 DST 3630-70 1hr rec 80' HOCM BHP 300/20 5½ 3773/100 JUL 10 '57 CO DD 3782 FU 1200'

FORM 513-1 SUNRAY

oil 2 3/4 hrs ⌀ 11 Bopd
h2o 3 hrs ⌀ 0 bwpd
Plug 248 No D

26-10-20W