

Section 26 Township 10 Range 20W

Well No. #2 Sutor

Company Nadel & Gussman

NORTH

							0

WEST

EAST

SOUTH

Sec. 26 Twp. 10 R. 20W ✓

Well No. #2 Sutor Farm

Nadel & Gussman Company

Contractor

Berland Pool


990' Ft. from N. Line

_____ Ft. from S. Line

330' Ft. from E. Line

_____ Ft. from W. Line

SE NE SE

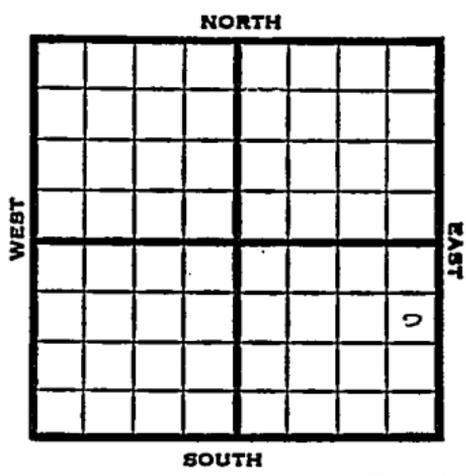

1950 Elv. 2173' REPORT

12/20 Location

1951
1/10 Spud 12-28-50
D&A TD 3801
8" @ 168 Heeb. 3414
Toronto 3435
Lans. . 3450 Cong. 3710-3801 TD
D&A

ABANDONED

