


Section 26 Township 10 Range 20 W

Well No. #1 Annon Heirs

Company Kaiser & Francis Oil & Gas

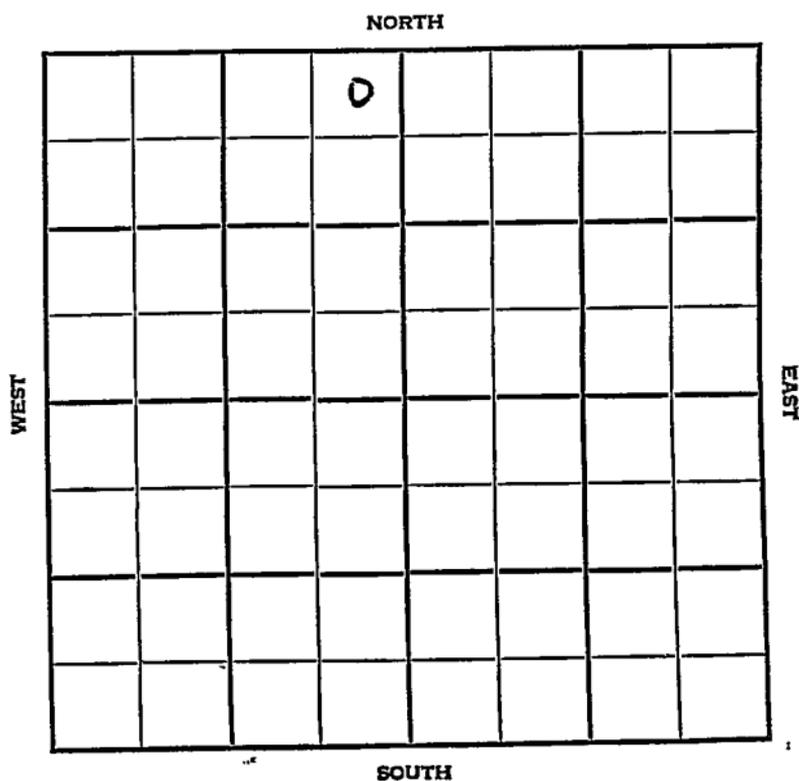

Rooks

KANSAS

SEC. 26	TWP. 10	R. 20W
------------	------------	-----------

WELL NO. #1 Annon Heirs FARM

COMPANY Kaiser & Francis Oil & Gas

CONTRACTOR Armer


SW Berland

_____ Ft. from N. Line

_____ Ft. from S. Line

_____ Ft. from E. Line

_____ Ft. from W. Line

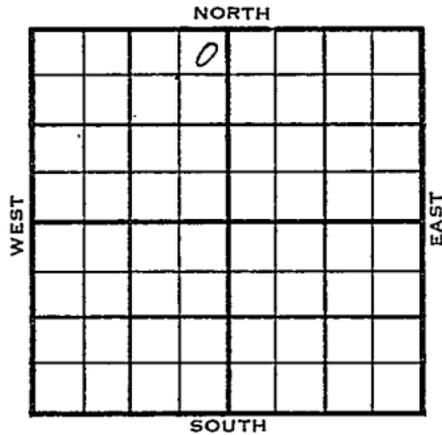

NE NE NW

1956	ELEVATION	REPORT
------	-----------	--------

2-15 Comm. 2-10-56
8" @ 199/150
Drlg. 2295'
Anh. 1670'

County Rocks Elev. _____
 Sec. 26 Twp. 10 Rgs. 20W
 Company Kaiser & Francis Oil & Gas
 Farm Name Annon Hairs No. 1

TOPS	DEPTH	LOG	DATUM	Loc. in Sec.
Anh.	<u>1670</u>			<u>NE NE NW</u>
Tp.				
H.				
Tr.				
Dg.				
Bl.				
L.				
K.C.				Geol. _____
B.K.C.				Contr. _____
Ce.				<u>Amner</u>
C.				
M.				
M.				Pool _____
K.				<u>SW Berland</u>
Mz.				<div style="border: 1px solid black; padding: 5px; text-align: center;"> <p>FIRST REPORT</p> <p>FEB 15 '56</p> </div>
Mq.				
V.				
S.				
S.				
A				
R.				
Pe.				
G.				
T.D.				

Date Comm. 2-10-56
8" @ 199/150 drlg. 2295

[Handwritten signature]

Co.
Lse.
No.
Sec.
T.
R.

3

County **Rooks** Elev. **2223**
 Sec. **26** Twp. **10** R. **20W**
 Company **Kaiser & Francis Oil & Gas**
 Farm Name **Annon Heirs** No. **1**

TOPS	DEPTH	LOG	DATUM	Loc. in Sec.
Ans	1670			NE NE NW
Tr				
H.	3458			
Tr.				
Dg.				
Bl.				
L.				
KC	3496		1273	Geol.
RKC				Contr.
Ce.	✓ 3743		1520	Armor
C.				
M.				
M.				Pool
K.				SW Berland
Mr.				
Mo.				
V.				
S.				
S.				
A.				
R.				
PC				
C.				
TD	3838			FEB 29 1956

Date Comm. **2-10-56**
 8" **199/150** drlg. 2295 FEB 22 '56

FEB 29 '56 *no test.*

H & A