

Section 26 Township 10 Range 20 WWell No. #1 ElizaCompany Francis Oil & Gas

NORTH

				0			

WEST

EAST

SOUTH

Rooks

KANSAS

SEC.	TWP.	R..
26	10	20W

WELL NO.

#1 Eliza

FARM

COMPANY

Francis Oil & Gas

CONTRACTOR

Armer


_____ Ft. from N. Line

_____ Ft. from S. Line

_____ Ft. from E. Line

_____ Ft. from W. Line

NW NW NE

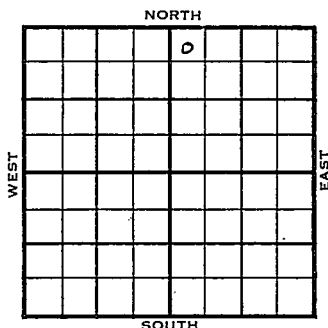

	ELEVATION	REPORT
1955	2201	
10/12	Location	
1956		
2-1	Comm. 10-31-55 8 5/8" @ 200/150 DST 3495-3545 op 1 hr. rec. 90' msw, 1160# DST 3621-82 op 1 hr. rec. 12' mud, 0# DST 3787-91 op 1 hr. rec. 50' oil, 390# DST 3790-96 op 1 hr. rec. 1010' ho, 965# 5 1/2" @ 3788/100 CO to 3796, FU 2600' oil 6 hrs., S/ 18 boph, 4 hrs. Comp. 50 bopd Anh. 1660 H. 3434 Tr. 3448 L. 3472 BKC 3686 Cherty 3716 S. 3761 A. 3786 TD 3796	

COMPLETED

County Rooks

Elev. _____

Sec. 26Twp. 10Rge. 20WCompany Francis Oil & GasFarm Name ElizaNo. 1

TOPS

DEPTH

LOG

DATUM

Loc. in Sec. _____

Anh. _____

Tp. _____

H. _____

Tr. _____

Dg. _____

Bl. _____

L. _____

K.C. _____

B.K.C. _____

Ce. _____

C. _____

M. _____

M. _____

K. _____

Mz. _____

Mq. _____

V. _____

S. _____

S. _____

A. _____

R. _____

P.E. _____

G. _____

T.D. _____

NW NW NE

Geol. _____

Contr. _____

Armer

Pool _____

		b	
OCT 12 55			
FIRST REPORT			

Co.

Lse.

No.

Sec.

T.

R.

Date Comm. _____

Location _____

County Rooks Elev. 2201
 Sec. 26 Twp. 10 Rge. 20W
 Company Francis Oil & Gas
 Farm Name Eliza No. 1

TOPS	DEPTH	LOG	DATUM	Loc. in Sec.
Anh.	1660			NW NW NE
Tr.				
H.	3434			
Tr.	3448			
Dg.				
Bl.				
L.	3472		1271	Geol.
K.C.				
B.K.C.	3686		1485	Contr.
Ce.				
C. <u>Cherty</u>	3716		1515	Armer
M.				
M.				Pool
K.				
Mz.				
Mq.				
V.				
S.	3761		1560	
S.				
A.	3786		1585	
R.				
PE.				
G.				
T.D.	3796			

COMPLETE

Date Comm. 10-31-55 FEB 1 1956

8 5/8" @ 200/150 DST 3495-3545

open 1 hr. rec. 90' msw 1160#

DST 3621-82 open 1 hr. rec. 12' mud

0# DST 3787-91 open 1 hr. rec.

50' oil 390# DST 3790-96

open 1 hr. rec. 1010' ho 965#

5 1/2" @ 3788/100 CO to 3796 FU 2600'

oil 6 hr. S/ 18 boph 4 hr.

Comp. 50 bopd