


Section 26 Township 10 Range 20W
Well No. #2 Eliza
Company Gulf Oil

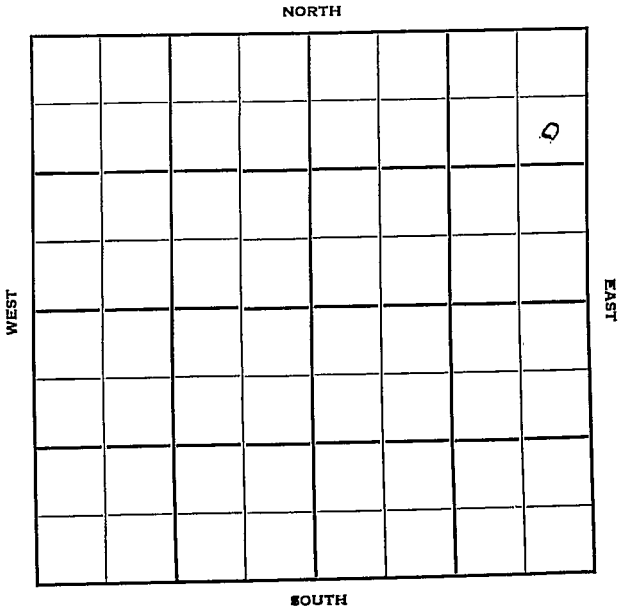

Rooks

KANSAS
20W

Sec. 26 Twp. 10 R. 20W

Well No. #2 Eliza Farm

Gulf Oil Company

Contractor


990' Ft. from N. Line

Ft. from S. Line

330' Ft. from E. Line

Ft. from W. Line

SE NE NE

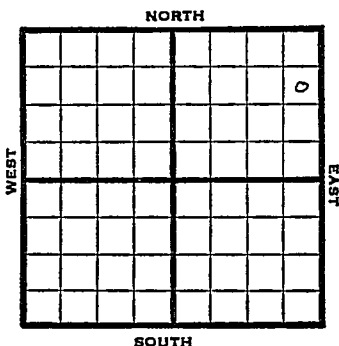

1950

Elev 2155

REPORT

4/26

Spud 4-22-50
Anhy 1585'
TD 1593'
Run 8"

5/10

TD 3860
8" @ 1593
Lans 3424
Cong 3683
Anb. 3828
No show
Dry and Abandoned

ABANDONED

Kansas


Map No. _____ Sec. 26 Twp. 10 R. 20WWell No. 2 Eliza

_____ Gulf Oil _____ Company

_____ Contractor

SE NE NE

SECTION PLAT

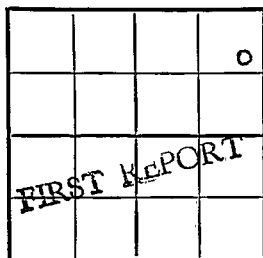990 Ft. from N. Line

_____ Ft. from S. Line

330 Ft. from E. Line

_____ Ft. from W. Line

Rooks County

Location _____

Rig up _____

Drilling and Remarks:

Spud 4-22-50

Anhy 1585

TD 1593

run 8"

RECORD

Cased _____ in., _____ ft.

Sand _____

Gas _____

Oil _____

Total Depth _____

PRODUCTION

1st 24 hrs. Nat. _____

1st 24 hrs. after shot _____

Gas _____ Cu. Ft.

Dry Hole _____

Abandoned _____

Date

APR 26 1950 19

J. E. TYRA Scout

Kansas

Map No. _____ Sec. 26 Twp. 10 R. 20WWell No. 2 ElizaGulf Oil Company

Contractor

SE NE NEE1. 2155
SECTION PLAT990 Ft. from N. Line Ft. from S. Line330 Ft. from E. Line Ft. from W. Line

			Q
ABANDONED			

Rooks

Location _____

Rig up _____

Drilling and Remarks:

8" @ 1593
Lans 3424
cong 3683
arb 3828
no shows
R + A

RECORD

Cased _____ in., _____ ft.

Sand _____

Gas _____

Oil _____

Total Depth 3860

PRODUCTION

1st 24 hrs. Nat. _____

1st 24 hrs. after shot _____

Gas 42.41 Cu. Ft.

Dry Hole _____

Abandoned _____

Date

MAY 10 1950

19

J. E. TYRA

Scout