
FORM 51 25M 3-49 PETROL Rooks KANSAS

Section 26 Township 10 Range 20W

Well No. #1 E. Sutter

Company Gulf

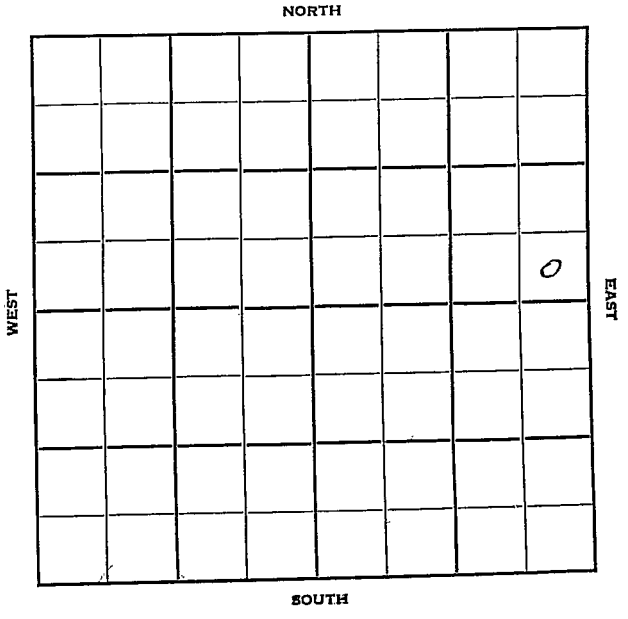

FORM 252-B
10M 9-49 PETROL


KANSAS Rooks

Sec. 26 Twp. 10 R. 20-W

Well No. #1 E Sutter Farm

Gulf Company

Contractor

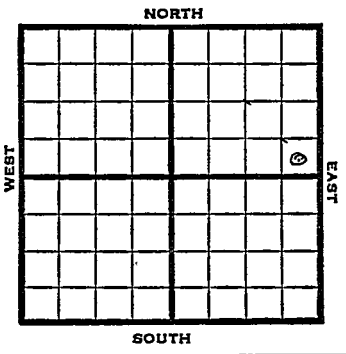

Ft. from N. Line

330 Ft. from S. Line

330 Ft. from E. Line

Ft. from W. Line

SE SE NE

1950	Elev 2165' REPORT
2/1 3/29	RUR TD 3749' 8"@ 1609' 5"@ 3747' Lans 3437' Simp 3726' Arb. 3746' 437 BOPD Comp COMPLETED

Form 26 200 Bks. 6-49 Petrol

Kansas

Wildcat

Map No. _____ Sec. 26 Twp. 10 R. 20W

Well No. 1 E. Sutter

Gulf Company

Contractor

SE SE NE

SECTION PLAT



_____ Ft. from N. Line

330 Ft. from S. Line

330 Ft. from E. Line

_____ Ft. from W. Line

Rooks County

Location _____

Rig up _____

Drilling and Remarks:

R U R

RECORD

Cased _____ in., _____ ft.

Sand _____

Gas _____

Oil _____

Total Depth _____

PRODUCTION

1st 24 hrs. Nat. _____

1st 24 hrs. after shot _____

Gas _____ Cu. Ft.

Dry Hole _____

Abandoned _____

Date

FEB 1 1950 19 J. E. TYRA Scout

Form 26 200 Bks. 11-49 Petrol

Kansas

Wildcat

Map No. _____ Sec. 26 Twp. 10 R. 20W

Well No. 1 E. Sutter


Gulf Company

Contractor

SE SE NE

El. 2165

SECTION PLAT

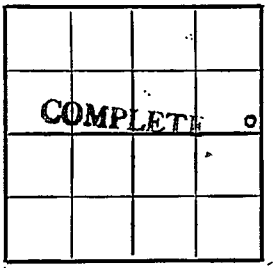

_____ Ft. from N. Line

330 Ft. from S. Line

330 Ft. from E. Line

_____ Ft. from W. Line

Rooks County

Location _____

Rig up _____

Drilling and Remarks:

8"@1609
5"@3747
Lans 3437
Simp 3726
Arb 3746
437 BOPD

RECORD

Cased _____ in., _____ ft.

Sand _____

Gas _____

Oil _____

Total Depth 3749

PRODUCTION

1st 24 hrs. Nat. _____

1st 24 hrs. after shot _____

Gas _____ Cu. Ft.

Dry Hole _____

Abandoned _____

Date C

MAR 29 1950 19

J. E. TYRA Scout