

Section 26 Township 10 Range 21 WWell No. # 2 Barber "A" S.W.DCompany Anderson-Prichard

NORTH							
							0
SOUTH							
WEST							EAST

Sec. 26 Twp. 10 R. 21 WWell No. #2 Barber "A" SW D FarmAnderson-Prichard

Company

Gleen Peel Drlg.

Contractor

White Pool990

Ft. from N. Line


Ft. from S. Line

330

Ft. from E. Line

Ft. from W. Line

SE NE NE

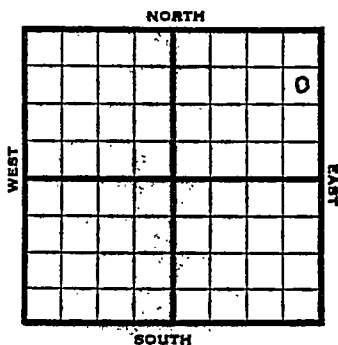

1953

Elev. 2133' REPORT

5/13

Spud 5-9-53

8" @ 205

Drlg. 2230'

5/20

Spud 5-9-53 D & A TD 3784

8" @ 205 Heeb 3384 Tor. 3412

Lans 3428 Cong. 3720 Arb. 3748

TD 3784' D & A

ABANDONED

County Graham State Kansas
 Sec. 26 (Blk.) 10 (Sur.) 21W Map No.
 (Twp.)
 Operator Anderson-Prichard
 Well No. 2 Farm Barber "A"
 Elev. Location SE NENE

							0

FIRST REPORT

990 Ft. From N Line NE
330 Ft. From E Line Quarter
 1st. Report MAY 13 1953

Completion

Remarks


Glenn Peel Drlg. - Contr.

Spudding Date 5-9-53

Drlg. Data White Pool

8" @ 205 drlg. 2230

County Graham State Kansas
 Sec. 26 (Blk. 10 (Sur. 21W Map No. (Twp.) (Rgs.))
 Operator Anderson-Prichard
 Well No. 2 Farm Barber "A"
 Elev. 2133 Location SE NE NE

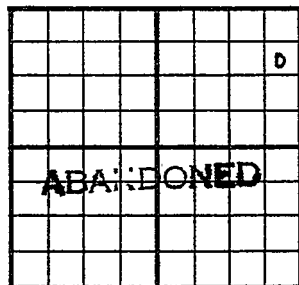

990 Ft. From N Line NE
330 Ft. From E Line Quarter

1st. Report

Completion MAY 20 1953

Remarks White Pool

Glenn Peel - Contr.

Spudding Date 5-9-53

Drlg. Data D & A TD 3784

8" @ 205 Heeb. 3384 Tor. 3412

Lans. 3428 Cong. 3720 Arb. 3748

TD 3784

D & A

J. G. McGEHEE

O.W.W.O.

FORM 513 SUNRAY

County Graham Elev. _____
 Sec. 26 Twp. 10 Rge. 21W
 Company Anderson-Pritchard
 Farm Name Barber "A" SWD No. 2

TOPS	DEPTH	LOG	DATUM
Anh.			
Tr.			
H.			
Tr.			
Dg.			
Bl.			
L.			
K.C.			
B.K.C.			
Ce.			
C.			
M.			
M.			
K.			
Mz.			
Me.			
V.			
S.			
S.			
A			
R.			
Pe.			
G.			
T.D.			

Loc. in Sec. _____

SE NE NE

(oww)

Geol. _____

Contr. _____

Peel Bros.

Pool _____

Laura

FIRST REPORT
 JUL 24 '57

Date Comm. _____

M I R

5

Co.

Lse.

No.

Sec.

T.

R.

County Graham Elev. 2136 RB
 Sec. 26 Twp. 10 Rge. 21W
 Company Anderson-Prichard
 FarmName Barber "A" SWD No. 2

TOPS	DEPTH	LOG	DATUM
Anh.			
TP.			
H.	3384		
Tr.	3412		
Dg.			
BL.			
L.	3428		
K.C.			
B.K.C.			
Ce.			
C.	3720		
M.			
M.			
K.			
Mz.			
Me.			
V.			
S.			
S.			
A.	3748		
R.			
Pe.			
G.			
T.D.	3784		

Loc. in Sec.

SE NE NE

(00000)

Geol.

County

Peel Bros.

Pool COOPER

Laura

AUG 7 '57

ABANDONED

Date Comm.

was DE'A.

M I R

JUL 31 '57

DD 4100. 5 1/2

3803 AUG 3 '57 CO 4100 12 input

#4,390 Bwpd complete
for SWD