3-10-26 PW

SIDE ONE

STATE CORPORATION COMMISSION OF KANSAS
OIL & GAS CONSERVATION DIVISION

WELL COMPLETION OR RECOMPLETION FORM
ACO-1 WELL HISTORY

DESCRIPTION OF WELL AND LEASE

Operator: license # 5146
name Rains & Williamson Oil Co., Inc.
address 435 Page Court, 220 W. Douglas
Wichita, KS 67202
City/State/Zip

Operator Contact Person Juanita M. Green
Phone 265-9686

Contractor: license # 5146
name Rains & Williamson Oil Co., Inc.

Wellsite Geologist
Phone
PURCHASER

Designate Type of Completion
(X) New Well ( ) Re-Entry ( ) Workover

[ ] Oil [ ] SWD [ ] Temp Abd
[ ] Gas [ ] Inj [ ] Delayed Comp.
[X] [ ] Other (Core, Water Supply etc.)

If OWWO: old well info as follows:
Operator
Well Name
Comp. Date Old Total Depth

API NO. 15 - 179-20,822

County Sheridan

100' E of SW SW NE Sec 3 Twp 10S Rge 26 [X] West
(location)

2970 Ft North from Southeast Corner of Section
2210 Ft West from Southeast Corner of Section
(Note: locate well in section plat below)

Lease Name Ziegler "A" Well# 2

Field Name

Producing Formation

Elevation: Ground 2564 KB 2573

Section Plat

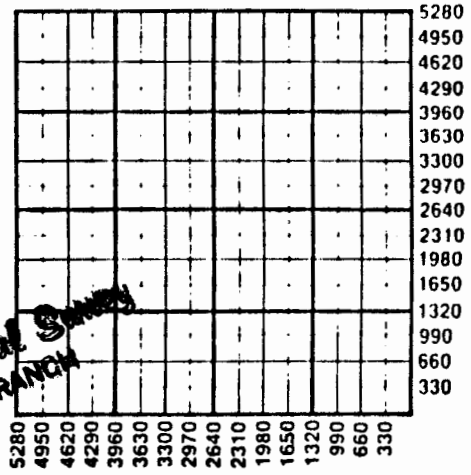

JUL 24 1985
State Geological Survey
WICHITA BRANCH

WELL HISTORY

Drilling Method: [X] Mud Rotary [ ] Air Rotary [ ] Cable

6-14-85 6-21-85 6-22-85
Spud Date Date Reached TD Completion Date

4100' .....
Total Depth PBTD

Amount of Surface Pipe Set and Cemented at 302' feet

Multiple Stage Cementing Collar Used? [ ] Yes [ ] No

If Yes, Show Depth Set feet

If alternate 2 completion, cement circulated
from feet depth to w/ SX cmt

[X] WATER SUPPLY INFORMATION

Source of Water:

Division of Water Resources Permit #

[ ] Groundwater Ft North From Southeast Corner an
(Well) Ft. West From Southeast Corner o
Sec Twp Rge [ ] East [ ] West

[ ] Surface Water Ft North From Southeast Corner an
(Stream, Pond etc.) Ft West From Southeast Corne
Sec Twp Rge [ ] East [ ] West

[ ] Other (explain)
(purchased from city, R.W.D.#)

Disposition of Produced Water: [ ] Disposal [ ] Repressuring

Docket #

INSTRUCTIONS: This form shall be completed in duplicate and filed with the Kansas Corporation Commission, 200 Colorado Derby Building, Wichita, Kansas 67202, within 90 days after completion or recompletion of any well. Rules 82-3-130 and 82-3-107 apply.

Information on side two of this form will be held confidential for a period of 12 months if requested in writing and submitted with the form. See rule 82-3-107