
FORM 51 25M 8-50 WESTERN Graham KANSAS

Section 27 Township 10 Range 23W

Well No. #1 Schultz

Company Heathman & Co.

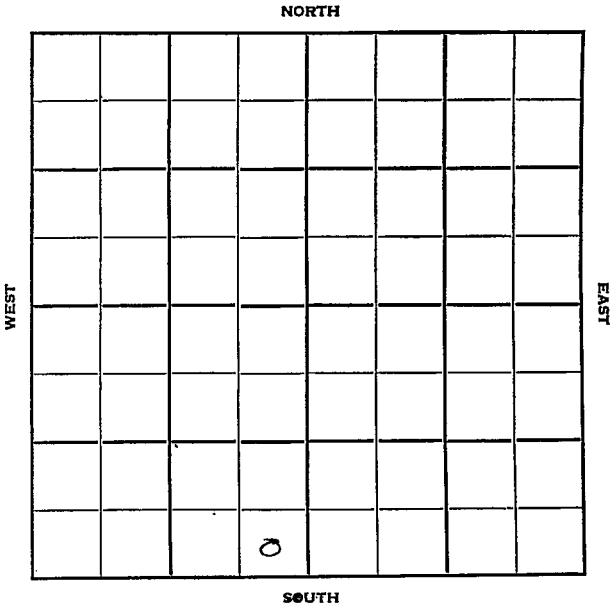

FORM 252-B
10M 8-51 TPCO.

Graham

KANSAS

Sec. 27 Twp. 10 R. 23W

Well No. #1 Schultz Farm

Heathman & Co. Company

Heathman - Contr. Contractor

Wildcat


Ft. from N. Line

330' Ft. from S. Line

330' Ft. from E. Line

Ft. from W. Line

SE SE SW

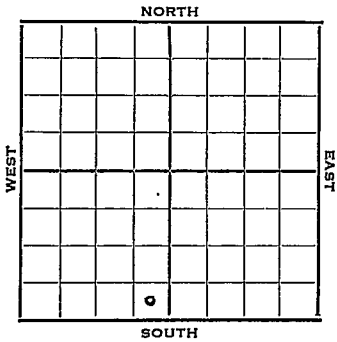

1951	Elev. 2307' . REPORT
12/12	Spud 12-10-51 8" @ 158 WOC
1952 1/2	Spud 12-10-51 D&A TD 4113 8" @ 158 Anhy 1820 Heeb. 3544 Lans. 3578 B KC 3806 Marm. 3915 Cong. 4006 Simp. 4059 Arb. 4084 DST 3586-3622 open ½ hr. rec. 186' mud & SW TD 4113 D&A

ABANDONED

4084
2307
1777

4084
3578
506

3577
2307
1271

FORM 275 FOR SALE BY KANSAS BLUE PRINT CO.


County Graham State Kansas

Sec. 27 (Blk. Twp.) 10 (Sur. Rge.) 23W Map No.

Operator Heathman & Co.

Well No. 1 Farm Schultz

Elev. Location SE SE SW

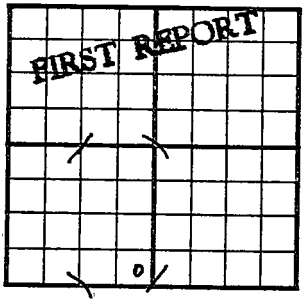

330 Ft. From S Line SW

330 Ft. From E Line Quarter

1st. Report DEC 1 2 1951

Completion

Remarks

Heathman - Contr.

Spudding Date 12-10-51

Drlg. Data Wildcat

8" @ 158 WOC

J. E. TYRA

FORM 275 FOR SALE BY KANSAS BLUE PRINT CO.


County Graham State Kansas

Sec. 27 (Blk. Twp.) 10 (Sur. Rge.) 23W Map No.

Operator Heathman & Co.

Well No. 1 Farm Schultz

Elev. 2307 Location SE SE SW

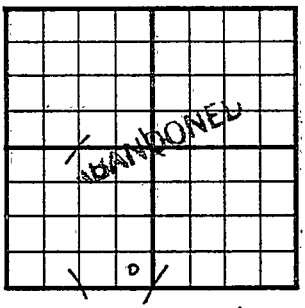

330 Ft. From S Line SW

330 Ft. From E Line Quarter

1st. Report

Completion JAN 2 1952

Remarks Wildcat

Heathman - Contr.

Spudding Date 12-10-51

Drlg. Data D & A TD 4113

8" @ 158 Anhy 1820 Heeb. 3544

Lans. 3578 B KC 3806 Marm. 3915

Cong. 4006 Simp. 4059 Arb. 4084

DST 3586-3622 open ½ hr. Rec. 186' mud & SW TD 4113

D & A

J. E. TYRA