

Graham

KANSAS

|      |      |     |
|------|------|-----|
| SEC. | TWP. | R.  |
| 27   | 10S  | 23W |

WELL NO.

I Schultz "A"

FARM

COMPANY

Birmingham &amp; Bartlett

CONTRACTOR


Happy Pool

\_\_\_\_\_ Ft. from N. Line

\_\_\_\_\_ Ft. from S. Line

\_\_\_\_\_ Ft. from E. Line

\_\_\_\_\_ Ft. from W. Line

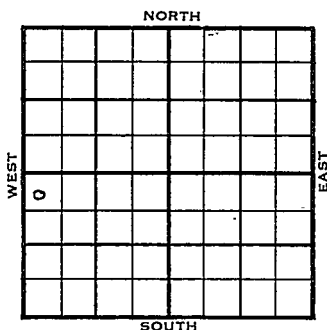

NW NW SW

1955

ELEVATION

2365'

REPORT

5/25

Heeb 3600; Tor 3620; Lsg 3636;  
 TD 3870; 8" 244;  
 DST 3751-81 open 45 min, rec 25' mud  
 20#; DST 3790-3814 open 20 min rec  
 15' mud, 0#; DST 3818-44 open 20 min,  
 rec 5' mud, 1110#;  
 DST 3846-70 open 20 min, rec 5' mud  
 0#; no log; no show  
 D&A

FIRST REPORT

✓

ABANDONED