

SECTION 27 TOWNSHIP 10S RANGE 15W

WELL NO. #2-Worley

COMPANY J-S-F & Durbin Bond

SW NW SE

NORTH

10

WEST

EAST

0


SOUTH

County Osborne Elev. _____
 Sec. 27 Twp. 10 Rge. 15W
 Company J-S-F & Durbin Bond
 Farm Name Worley No. 2

TOPS	DEPTH	LOG	DATUM	Loc. in Sec.
Anh.	943			SW NW SE
TP.	2691			
H.				
Tr.				
Dg.				
Bl.				
L.				Geol. _____
K.C.				Contr. _____
B.K.C.				
Ce.				Co. tools
C.				
M.				Pool
M.				S. Ruggles
K.				
Mz.				
Mq.				
V.				
S.				
S.				
A.				
R.				
PC.				
G.				
T.D.				

FIRST REPORT
 JUL 10 '57

Date Comm. 7-3-57
8" @ 202/100 DST 2712-44 open 1/2 hr.
rec. 10' drlg. mud, scum oil 300/20"
drlg.

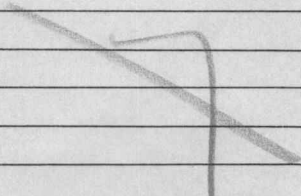

Co.
 Lse.
 No.
 Sec.
 T.
 R.

County Osborne Elev. 1816
 Sec. 27 Twp. 10 Rge. 15W
 Company J. S. F. & Durbin Bond
 Farm Name Worley No. 2

TOPS	DEPTH	LOG	DATUM
Anh.	913		
Tp.	2691		
H.	2939		
Tr.	2959		
Dg.			
Bl.			
L.	2988		
K.C.			
B.K.C.	3249		
Ce.			
C.	3331		
M.			
M.			
K.			
Mz.			
Ma.			
V.			
S.			
S.			
A.			
R.			
Pe.			
G.			
T.D.	3363		

Loc. in Sec. SW NW SE

Geol. _____
 Contr. _____
 Co. tools _____

Pool _____
S. Ruggles



Date Comm. 7-1-57
8" @ 202/100 DST 2712-1/4 open 1 hr.
rec. 10' drlg. mud, scum oil 300/20"
drlg. 21 17 57 DST 3047-74 1hr
rec 63' WCM BHP 1020/20"
DST 3078-3100 1hr rec 123'
WCM 880/20"
DEA

Co.

Use.

No.

Sec.

T.

R.