


Map No. 27 Sec. 10 Twp. 16^W
 Well No. #1 Nelson Farm
Carmen & Hershey Company

NORTH

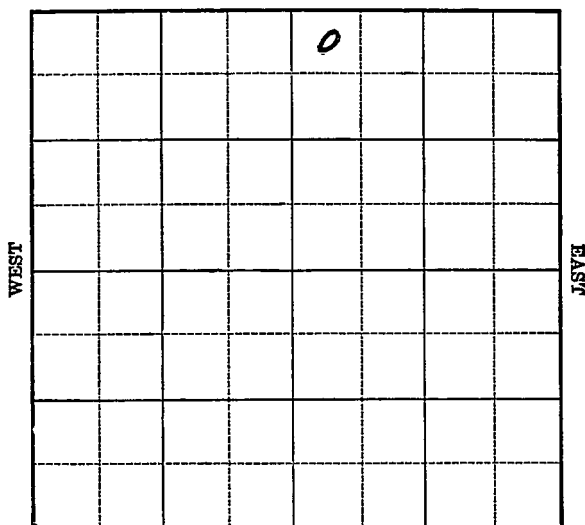

SOUTH

Location _____

Drilling Remarks _____

Rig Up _____

Drilling Remarks _____

RECORD

Cased _____ in. _____ ft.

Sand _____

Gas _____

Oil _____

Total Depth _____

PRODUCTION

1st 24 hrs. Nat. _____

1st 24 hrs. after shot _____

Gas _____ cu. ft.

Dry Hole _____

Abandoned _____

Rooks

Map No. 1225 Sec. 27 Twp. 10 R. 16^W
Well No. 1 Nelson Farm
Carmen & Hershey Company

NORTH

330

Ft. from N. Line

Ft. from S. Line

Ft. from E. Line

330

Ft. from W. Line

WEST

EAST

SOUTH

Date 7/35

REPORT

2/6 Ponds
2/14 BR
2/21 Rig
2/28 — 3/7 — 3/14 — 3/21 —
3/28 Moving In
4/4 Rgn
4/11 —
4/18 Spud
4/26 — 5/2 — 5/9 — 5/16 — 5/23 —
5/29 — 6/6 — 6/13 — 6/20 —
6/28 Dlg 1248
7/3 " 1360 12" 1287
7/11 " 2115
7/18 " 2625 10" 2484
8/8 8" 3045 20 3255-66
Oswell 3345 Dlg 3395
8/5 40 3422-27
HFW 3435- 6" 3442 Dlg 3475
8/22 Dlg 3641
8/29 5" 3661 HFW 3693-95 T7 S7.

(OVER)

9/6 SD 3722

9/20 Orville 3345

TD 3816

No A.

ABANDONED

Map No. 64 Sec. 27 Twp. 10 R. 16WWell No. 1- NelsonCoggeson & Hershey CompanyCarmen Contractor

FIRST REPORTS

SECTION PLAT

330 Ft. from N. Line

..... Ft. from S. Line

..... Ft. from E. Line

330 Ft. from W. Line

		0	

Location.....

Rig up.....

Drilling and Remarks:

RECORD

Cased.....in.,ft.

Sand.....

Gas.....

Oil.....

Total Depth.....

PRODUCTION

1st 24 hrs. Nat.....

1st 24 hrs. after shot.....

Gas.....Cu. Ft.

Dry Hole.....

Abandoned.....

Date

ORVAL MANNSCHRECK

2-6-35 192.....Scout

Map No. 64 Sec. 27 Twp. 10 R. 16WWell No. 1-NelsonCarmen & Hershey CompanyKANSAS Contractor

DOWED

SECTION PLAT

330 Ft. from N. Line

..... Ft. from S. Line

..... Ft. from E. Line

330 Ft. from W. Line

		O	

Location.....

Rig up.....

Drilling and Remarks:

Orval 3345NRH

RECORD

Cased.....in.,ft.

Sand.....

Gas.....

Oil.....

Total Depth 3816

PRODUCTION

1st 24 hrs. Nat.....

1st 24 hrs. after shot.....

Gas.....Cu. Ft.

Dry Hole.....

Abandoned.....

ORVAL MANNSCHRECK

Date

9-20-35 192

Scout