


Section 27 Township 10 Range 19 W

Well No. # 1 O'Brien

Company C & G Drilling

NORTH

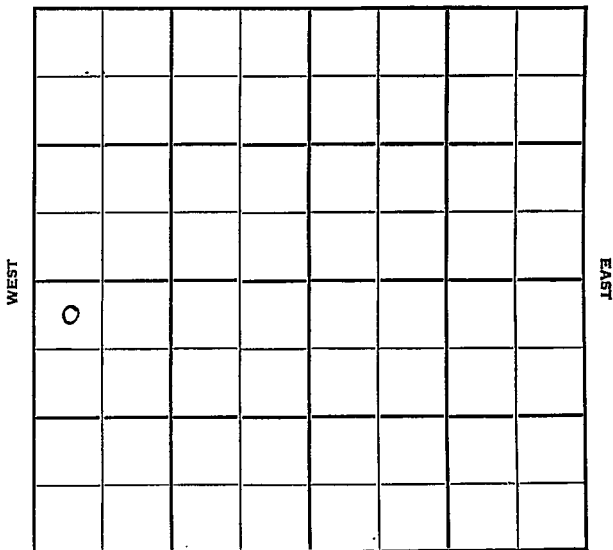

SOUTH

Sec. 27 Twp. 10 R. 19W

Well No. #1 O'Brien Farm

C & G Drlg. Company

C & G Drlg. - Contr. Contractor

Wildcat


330' Ft. from N. Line

_____ Ft. from S. Line

_____ Ft. from E. Line

330' Ft. from W. Line

NW NW SW

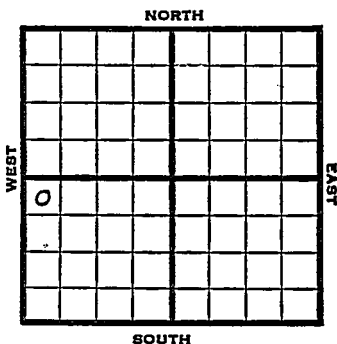

1951 Elev. 2183' REPORT

7/3 Spud 6-30-51
8" @ 190

7/18 Drlg. 1330'
Spud 6-30-51

D & A TD 3741' 8" @ 190

Heeb 3364' Tor 3387' Lans 3402'

Cong 3658' Simp. 3707' Arb. 3726-41' TD

D & A

ABANDONED

County Rooks State Kansas

Sec. 27 (Blk. Twp.) 10 (Sur. Rge.) 19 W Map No.

Operator C & G Drilling

Well No. 1 Farm O'Brien

Elev. 2183 Location NW NW SW

330 Ft. From N Line SW

330 Ft. From W Line Quarter

Ist. Report JUL 3 1951

Completion _____

Remarks _____

C & G Drlg. - Contr.

Spudding Date 6-30-51

Drlg. Data Wildcat

8" @ 190' Drlg. 1330

County _____ Rooks State Kansas

Sec. 27 (Blk. Twp.) 10 (Sur. Rge.) 19W Map No. _____

Operator C & G Drlg.

Well No. 1 Farm O'Brien

Elev. 2183 Location NW NW SW

330 Ft. From N Line SW

330 Ft. From W Line Quarter

Ist. Report _____

Completion JUL 18 1951

Remarks Wildcat

C & G Drlg. - Contr.

Spudding Date 6-30-51

Drlg. Data D & A TD 3741

8" @ 190 Heeb. 3364 Tor. 3387

Lens. 3402 Cong. 3658 Simp. 3707

Arb. 3726-41 TD

D & A

J. E. TYRA