


Rooks

KANSAS

SECTION 27 TOWNSHIP 10 RANGE 20 WWELL NO. #1 Pougé (Leonard) & PrimeCOMPANY Isern Drlg.

NORTH

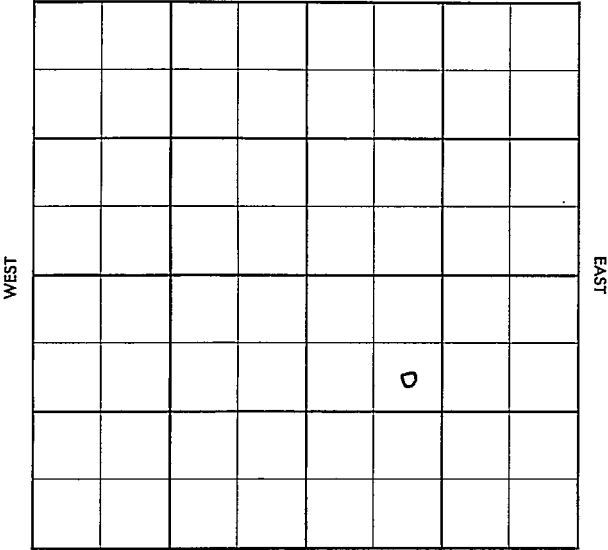

SOUTH

Rooks

KANSAS

SEC. 27	TWP. 10	R.. 20W
------------	------------	------------

WELL NO.

#1 Pauge

FARM

COMPANY

Isern Drlg. (Leonard) & Prime

CONTRACTOR

Prime Drlg.

Annon


_____ Ft. from N. Line

_____ Ft. from S. Line

_____ Ft. from E. Line

_____ Ft. from W. Line

SE NW SE

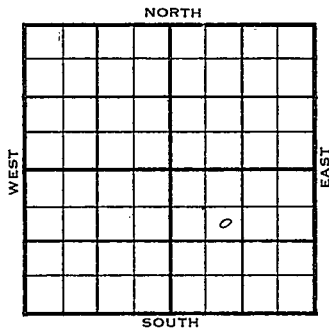

1955

ELEVATION

REPORT

12-7

RUR

County Rooks Elev. _____
 Sec. 27 Twp. 10 Rge. 20W
 Company Isern Drlg.
 Farm Name Pouge No. 1

TOPS	DEPTH	LOG	DATUM	Loc. in Sec.
Anb.				SE NW SE
TP.				
H.				
Tr.				
Dg.				
BL.				
L.				Geol.
K.C.				Contr.
B.K.C.				Prime Drlg.
Ce.				Pool
C.				Annon
M.				
M.				
K.				
Mz.				
Me.				
V.				
S.				
S.				
A.				
R.				
PE.				
G.				
T.D.				

FIRST REPORT

DEC 7 5⁰

Date Comm.

R U R

CORRECTION

FORM 513 REV. SUNRAY

County Rooks Elev. 2114
 Sec. 27 Twp. 16 Rge. 20W
 Company Isern Dril. (Leonard) & Prime
 Farm Name Pouge No. 1

TOPS	DEPTH	LOG	DATUM	Loc. in Sec.
Ank.	1545			SE NW SE
Top				
H.	3350			
Tr.				
Dg.				
Bl.				
L.	3390		1276	Geol.
K.C.				Contr.
RXC.				Prime Drilg.
Ce.				Pool
C.				Annon
M.				
M.				
K.				
Mr.				
No.				
V.	3692		1578	COMPLETE
S.	3695		1581	
S.				
A.				
R.				
PE				
C.				
TR	3702			

Date Comm. FEB 22 1956

RUR DEC 14 '55 12-5-55 85/8 209

1150 3206 DEC 21 '55 DST 3690-3702

1hr 305' GSW rec 1280' oil

FP 450' BHP 800 5 1/2 3697

DEC 28 '55 CO 3702 8 6 Boph 201W

4 hrs 15' 15 Boph 900' oil

Pop JAN 5 '56 JAN 11 '56 JAN 18 '56

JAN 25 '56 FEB 1 '56 FEB 8 '56 FEB 15 '56

FEB 22 '56 Ph P 174 Bopp + 5% W