


Rooks

KANSAS

SECTION 27 TOWNSHIP 10S RANGE 20W

WELL NO. #3 Poague

COMPANY Artnell & Prime

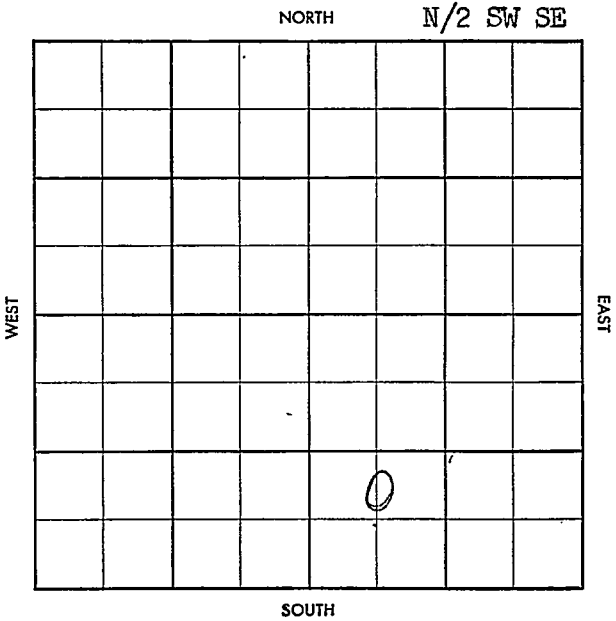

CO. Rooks ELEV. 2217 DF
SEC. 27 TWP. 10 RGE. 20W
COMPANY Artnell & Prime NO. 3

OCT 9 57

ABANDONED

FARM Poague
LOC. N/2 SW SE

Tops	
Anhy	1540
H	3364
TK	3382
L	3406
BKC	3613
C	3650
A	3711
TD	3735

GEOL. _____
CONTR. Prime Drl. tools
POOL Trico
SPUD 9-27-57
8" @ 228 w/140, Drlg.
2525 1.9 97
DST 3710-18
60" 7' M FP 12-30
13 HP 448/20" DST
3718-35 60" 51'

MLY W FP 95-45 BHP
775/20"

DBA

CO.
NO.
SEC.
TWP.
RGE.