


Section 27 Township 10 Range 20 W

Well No. # 1 Towns

Company Derby Oil & Champlin

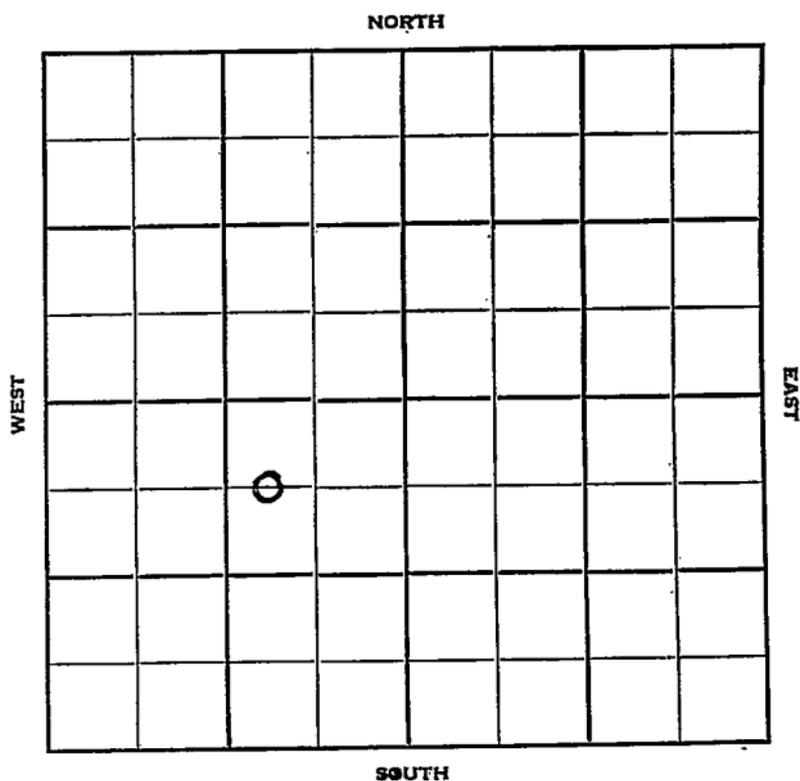

Sec. 27 Twp. 10 R. 20W

Well No. #1 Towns Farm

Derby Oil & Champlin Company

Champlin - Contr. Contractor


330
~~660~~ Ft. from N. Line

Ft. from S. Line

660
~~990~~ Ft. from E. Line

Ft. from W. Line

C N L N E S W
~~C W L N E S W~~

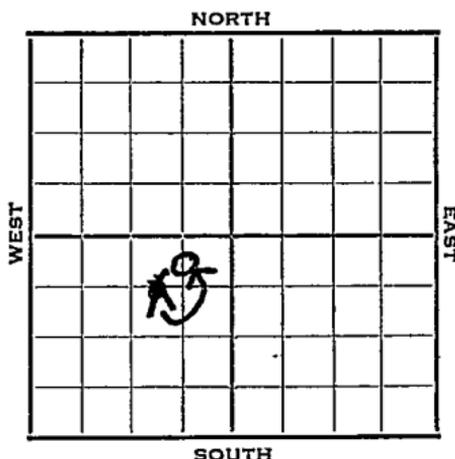

1952 Elev. 2132' REPORT

6/4 Spud 6-1-52
8" @ 258
WOC

6/11 Drlg. 3650'

6/18 Spud 6-1-52
D&A TD 3757' 8" @ 258'
Heeb. 3378 Lans. 3414
B KC 3618 Cong. 3655
DST 3655-92 open 1 hr.
rec. 7' mud Arb. 3746'
TD 3757' D&A

ABANDONED

County **Rooks** State **Kansas**

Sec. **27** (Blk. Twp.) **10** (Sur. Rge.) **20W** Map No.

Operator **Derby Oil & Champlin**

Well No. **1** Farm **Towns**

Elev. Location **C W L NE SW**

FIRST REPORT																			
										0									

660 Ft. From **N** Line **SW**

990 Ft. From **E** Line **Quarter**

Ist. Report **JUN 4 1952**

Completion

Remarks

Champlin - Contr.

Spudding Date **6-1-52**

Drlg. Data **Annon Pool**

8" @258 WOC

Map No. _____ Sec. 27 Twp. 10 R. 20W

Well No. 1 Towns

Derby & Champlin Company

CORRECTION Contractor

C N L NE SW

SECTION PLAT

330 Ft. from N. Line

_____ Ft. from S. Line

660 Ft. from E. Line

_____ Ft. from W. Line

	o		

Rooks County

Location _____

Rig up _____

Drilling and Remarks:

Reported

C W L NE SW

RECORD

Cased _____ in., _____ ft.

Sand _____

Gas _____

Oil _____

Total Depth _____

PRODUCTION

1st 24 hrs. Nat. _____

1st 24 hrs. after shot _____

Gas _____ Cu. Ft.

Dry Hole _____

Abandoned _____

Date

JUN 11 1952 19

J. G. MCGEHEE

Scout

