

Section 27 Township 10 Range 20W

Well No. #1 Williams

Company Derby Oil & Champlin

NORTH

	0						

WEST

EAST

SOUTH

Rooks

KANSAS

Sec. 27 Twp. 10 R. 20 W ✓

Well No. # 1 Williams Farm

Derby Oil & Champlin Company

Derby & Champlin Contractor

Marcotte Pool


330 Ft. from N. Line

\_\_\_\_\_ Ft. from S. Line.

\_\_\_\_\_ Ft. from E. Line

330 Ft. from W. Line

NW NW NW

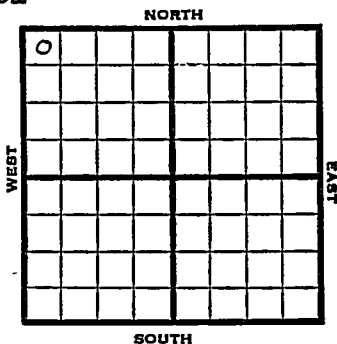

1951

Elev. 2159' REPORT

6/13  
6/27

R U R  
Spud 6-14-51  
D&A TD 3781  
8" @ 257  
Heeb. 3411 Lans. 3447  
Cong. 3702-81 TD  
D&A

**ABANDONED**

County Rooks State Kansas

Sec. 27 (Blk. Twp.) 10 (Sur. Rge.) 20W Map No.

Operator Derby Oil & Champlin

Well No. 3 Farm Williams

Elev. \_\_\_\_\_ Location NE 1/4 NE 1/4 NE 1/4

0					

330 Ft. From N Line 1/4

330 Ft. From W Line Quarter

1st. Report Jan 13 1931

Completion \_\_\_\_\_

Remarks \_\_\_\_\_

Derby & Champlin - Contr.

Spudding Date \_\_\_\_\_

Drig. Data \_\_\_\_\_

P U P

Marcotte Pool

County Rooks State Kansas

Sec. 27- (Blk. 10 (Sur. 20W (Twp.) (Rge.) Map No.

Operator Derby Oil & Champlin Ref.

Well No. 1 Farm Williams

Elev. 2159 Location NW NW NW

D					

330 Ft. From N Line NW

330 Ft. From W Line Quarter

1st. Report

Completion JUN 27 1951

Remarks Marcotte Pool

Derby & Champlin - Contr.

Spudding Date 6-14-51

Drig. Data D & A TD 3781

8" @ 257 Heeb. 3411 Lans. 3447

Cong. 3702-81 TD

D & A

J. E. TYRA