


Section 27 Township 10 Range 20W

Well No. #3 Williams

Company Derby Oil & Champlin Ref.

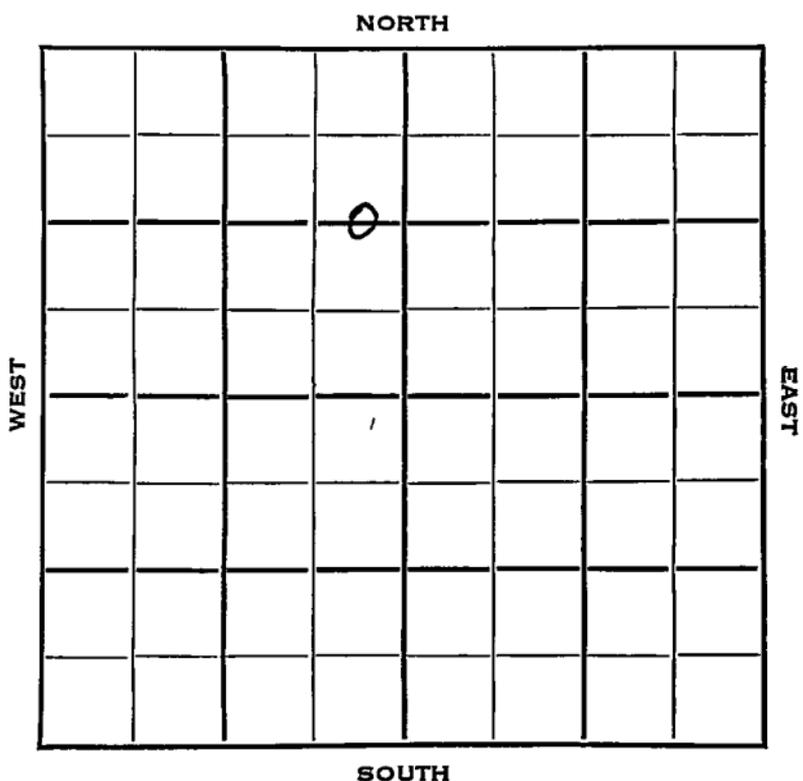

Rooks **KANSAS** ✓  
10 R. 20W

Sec. 27 Twp. 10 R. 20W

Well No. #3 Williams Farm

Derby Oil & Champlin Ref. Company

Champlin Contractor  
Annon


1320 Ft. from N. Line

Ft. from S. Line

330 Ft. from E. Line

Ft. from W. Line

E/2 E/2 NW

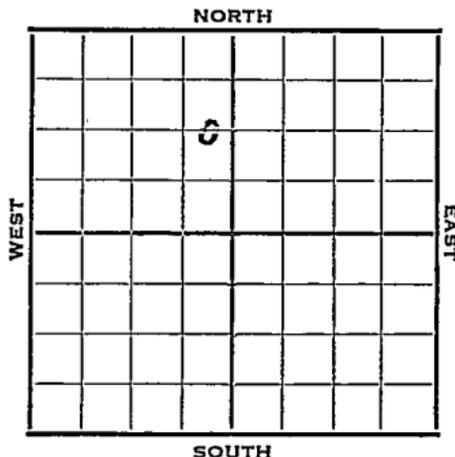

1953 Elev. 2127' REPORT

7/14 MIRT  
7/22 8" @ 164 w/125  
Drlg. 3020'

7/29 Heeb 3358, Tor 3380, Lans 3395  
DST 3476-83, 1-1/4 hrs., 210' SMCSW,  
1310#  
Arb. 3691-95 RTD  
5" @ 3692'

8/5 "

8/26 Spud 7-15-53 Oil well TD 3702'  
8" @ 164 Heeb 3358 Tor. 3380  
Lans 3395  
DST 3476-83 open 1 1/4 hr rec 210' SMCSW  
1310# Arb. 3691 TD 3695  
5" @ 3692 GO to 3695 B/4 GW 1 hr.  
DD 3696 B/7 GOPH DD 3698 10 GO 1 hr.  
500 A S/4 BOPH 5 hr. DD 3702  
2000 A S/1 1/4 BO 3 hrs. P/101 BO 24 hr.  
Comp. 132 BOPD

**COMPLETED**

County Rooks State Kansas

Sec. 27 (Blk. Twp.) 10 (Sur. Rgs.) 20W Map No.

Operator Derby Oil & Champlin Ref.

Well No. 3 Farm Williams

Elev. \_\_\_\_\_ Location E/2 E/2 NW


1320 Ft. From N Line NW

330 Ft. From E Line Quarter

Ist. Report JUL 14 1953

Completion \_\_\_\_\_

Remarks \_\_\_\_\_

Champlin-Contr.

Spudding Date \_\_\_\_\_

Drig. Data Annon - Contr.

**MTRT**

J. G. MCGEHEE

