


Section 27 Township 10 Range 21W

Well No. #1 Oil

Company Phillips Pet.

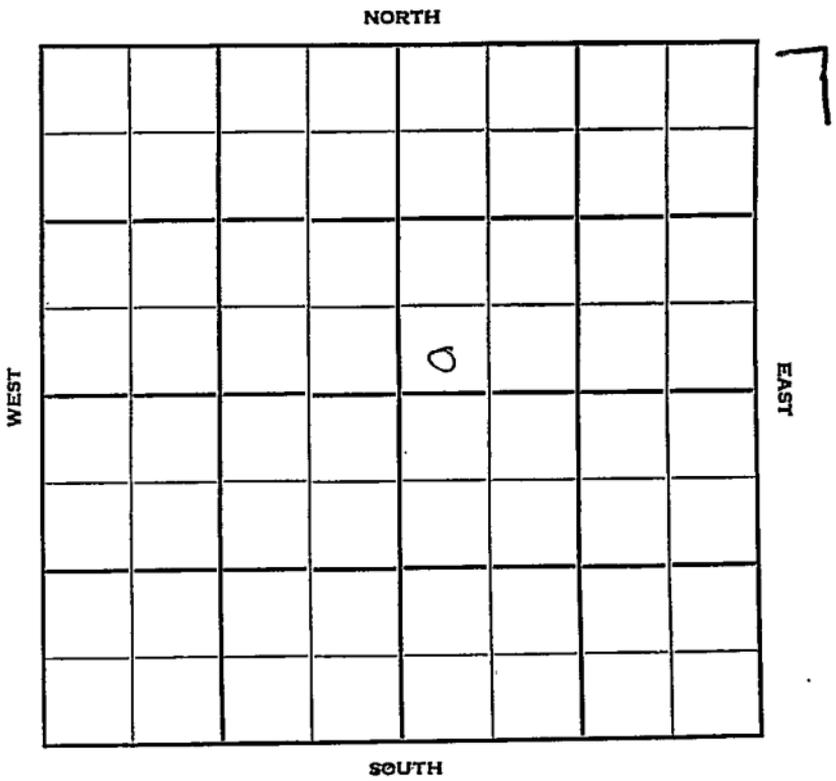

Sec. 27 Twp. 10 R. 21W

Well No. #1 Oil Farm

Phillips Pet. Company

Phillips Contractor


2310 Ft. from N. Line

..... Ft. from S. Line

2310 Ft. from E. Line

..... Ft. from W. Line

SW SW NE

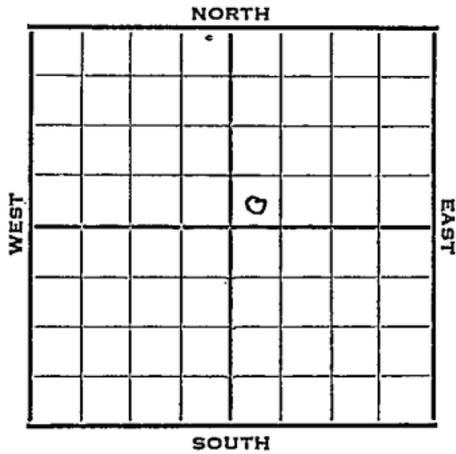

1952 Elev. 2180' REPORT

- 6/25 MIR
- 7/2 8" @ 253 Schl Tops:  
Topeka 3237 Heeb. 3418  
Tor 3444 Lans. 3458  
BKC 3686 Marm 3699  
Arb. 3763  
TD 3768
- 7/9 5" @ 3766 DP
- 7/17 DP 3768 2 gals & some wtr DD 3773  
S/5-3/4 BO 2 hrs. DD 3775 S/9 BO  
3 hrs. 500 A S/49 BO 16 hrs.  
DD 3779 1/2 1500 A S/46 1/2 BO 23 hrs.  
DD 3785 B/28 bo & 1/2% AW 11 hrs.  
To Hyd.
- 7/23 Hyd. 317 Bw 2 hrs. PB 3770'  
S/ 5 BW 1 hr. DO 3775 S/ 1 1/4 BO  
& 56 1/2 BW 16 hrs. DP 3778 SD
- 7/30 S/58 BO plus 36 BW PB 3737'  
28/3651-58 500 A S/40 BO plus 6 1/2  
BW 9 hrs. S/4 1/2 BO plus 3/4 BWPH for  
14 hrs. POP
- 8/6 NR
- 8/13 "
- 8/20 "
- 8/27 NR

OVER

1952

9/4

Spud 6-23-52

Oil Well TD 3785 8" @ 253'

Top. 3237 Heeb. 3418

Top. 3444 Lans. 3458

B KC 3686 Marm. 3699

Arb. 3763

5" @ 3766 TD 3768 2 go DD 3773

S/ 5-3/4 bo 2 hr. DD 3775 S/ 9 bo

3 hr. 500 A S/ 49 bo 16 hr.

DD 3779 1500 A S/ 46 bo 23 hr.

DD 3785 B 28 bo Hydro. 317 bw

2 hr. PB 3770 S/ 5 bw 1 hr.

DO to 3775 S/ 1 1/4 bo 56 1/2 bw 16 hr.

DP to 3778 S/ 58 bo 36 bw

PB 3737 28/ 3651-58 500 A S/ 10

bo 6 1/2 bw 9 hr. S/ 4 1/2 bo 3/4 bwph

Comp. 34 bopd 52% wtr.

**COMPLETED**

County **Graham** State **Kansas**

Sec. **27** (Blk. Twp.) **10** (Sur. Rge.) **21W** Map No.

Operator **Phillips Pet.**

Well No. **1** Farm **Oil**

Elev. Location **SW SW NE**


0

FIRST REPORT

**2310** Ft. From **N** Line **NE**

**2310** Ft. From **E** Line Quarter

1st. Report **JUN 25 1952**

Completion

Remarks

**Phillips - Contr.**

Spudding Date

Drlg. Data

**MIR**

**J. G. McGEHEE**

