


Section 27 Township 10 Range 21WWell No. #2 Noah "D" #1 VirginiaCompany Jones, Shelburne & Farmer

NORTH

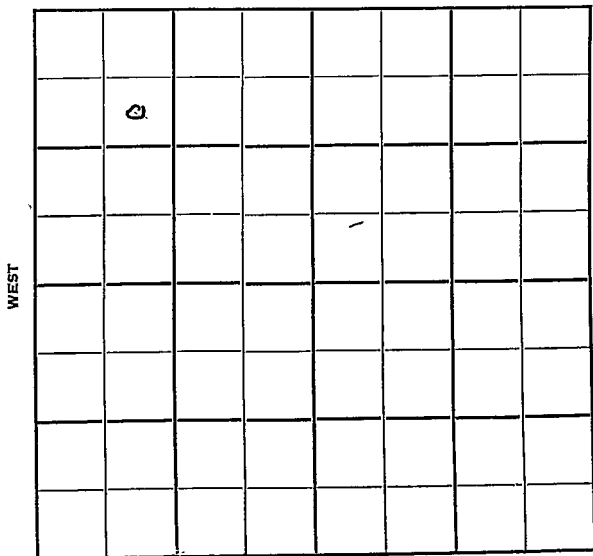

SOUTH


Sec. 27 Twp. 10 R. 21WWell No. #1 Virginia
#2 Noah "D" FarmJones, Shelburne & Farmer CompanyJ S F Contractor990 Ft. from N. Line

Ft. from S. Line'

Ft. from E. Line

990 Ft. from W. Line

SE NW NW

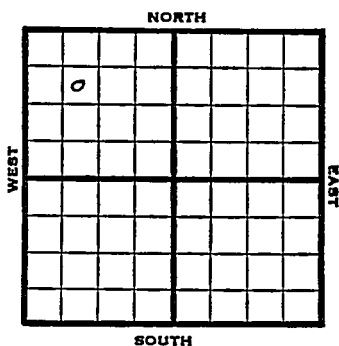

1952

Elev. 2210' REPORT

11/12	RUR
11/20	Dr1g. 3324'
11/27	Heeb 3452, Tor 3478, Lans 3492 DST 3692-3706, 1 hr., 1040' SW 1190# B KC 3723, Marm 3736, Arb 3803 DST 3805-10, 1 hr., 10' m 51' oil TD 3810'
12/4	5" @ 3807 C03810 550 250A S/2 BOPH
12/11	750A no help POP
12/18	P/15 BOPOL
12/25	" "
1/1	P/15 BOPD
1/8	NR
1/22	NR
1/29	"
2/5	NR
2/12	NR
2/19	NR
2/26	NR
3/12	NR

OVER

1953
3/19 NR
3/26 46 BOPD
4/1 Spud 11-11-52
Oil Well
TD 3810'
8" @ 142
Anhy 1680, Heeb 3452, Tor 3478,
Lans 3492,
DST 3692-3706 open 1 hr. Rec 1040'
sw 1190#
B KC 3723, Marm 3736, Arb 3803,
DST 3805-10 open 1 hr. Rec 51' hvy oil
930#
TD 3810
5" @ 3807'
CO to 3810
250A S/ 2 boph 750A P/ 15 bopd
P/ 14 bopd P/ 11 bopd
Comp. 46 bopd

COMPLETED

County Graham State Kansas
 Sec. 27 (Blk. Twp.) 10 (Sur. Rge.) 21W Map No. _____
 Operator Jones, Shelburne & Farmer
 Well No. 2 Farm Noah "D"
 Elev. _____ Location SE NW NW

0							

990 Ft. From N Line NW
990 Ft. From W Line Quarter

1st. Report NOV 12 1952

Completion _____

Remarks _____

J-S-F - Contr.

Spudding Date _____

Drlg. Data Noah Pool

RUR

Kansas

Map No. _____ Sec. 27 Twp. 10 R. 21WWell No. 1 VirginiaJones, Shelburne & Farmer CompanyCORRECTION Contractor


SE NW NW

SECTION PLAT

990 Ft. from N. Line

_____ Ft. from S. Line

_____ Ft. from E. Line

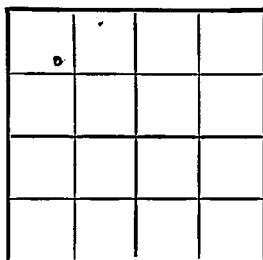990 Ft. from W. LineGraham County

Location _____

Rig up _____

Drilling and Remarks:

Reported
#2 Noah "D"

RECORD

Cased _____ in., _____ ft.

Sand _____

Gas _____

Oil _____

Total Depth _____

PRODUCTION

1st 24 hrs. Nat. _____

1st 24 hrs. after shot _____

Gas _____ Cu. Ft.

Dry Hole _____

Abandoned _____


Date

JAN 21 1953

19

J. G. McGEHEE Scout

County Graham State Kansas
 Sec. 27 (Blk.) 10 (Sur.) 21W Map No.
 Operator Jones, Shelburne & Farmer
 Well No. 1 Farm Virginia
 Elev. 2210 Location SE NW NW

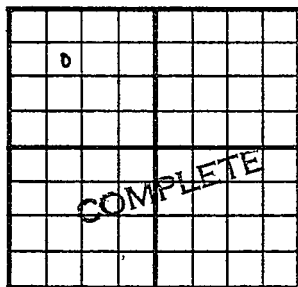

990 Ft. From N Line NW
990 Ft. From W Line Quarter
 1st. Report
 Completion APR 1 1953
 Remarks Noah Pool
J-S-F - Contr.
 Spudding Date 11-11-52

Drig. Data Oil well TD 3810
8" @ 142 Anhy 1680 Heeb. 3452
Tor. 3478 Lans. 3492 DST 3692-3706
open 1 hr. Rec. 1040' sw 1190#
B KC 3723 Marm. 3736 Arb. 3803
DST 3805-10 open 1 hr. Rec. 51' hvy oil
930# TD 3810 5" @ 3807 CO to 3810
250 A S/ 2 boph 750A'
P/ 15 bopd P/14 bopd P/ 11 bopd
Comp. 46 bopd