


KANSAS

FORM 51 5M BR1X

Section 27 Township 10 Range 22W

Well No. #1 Faulkner

Company Fred Koch Woodriven et al

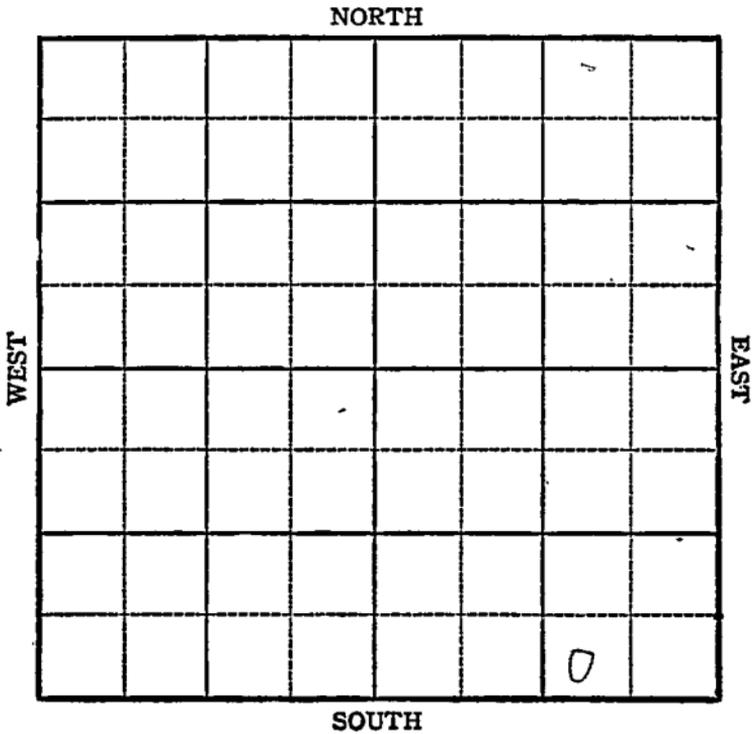

Sec. 27 **KANSAS** Twp. 10 R. 22W

Well No. #1 Faulkner Farm  
~~Fred Koch~~ Woodriver et al Company


Wildcat

\_\_\_\_\_ Ft. from N. Line

330 Ft. from S. Line

990 Ft. from E. Line

\_\_\_\_\_ Ft. from W. Line

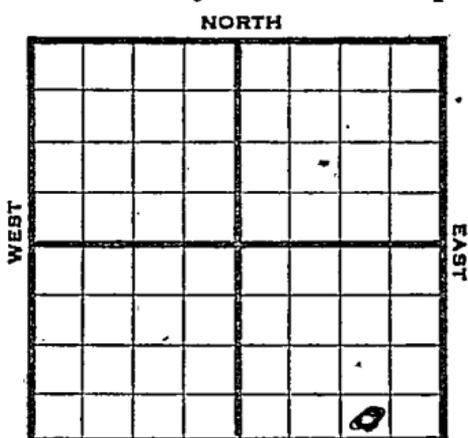

SW SE SE Elm. 2313 SOUTH

1944 REPORT

12/6	SH	
12/14	"	
12/21	8" @ 295	
	Anhy 1825	
	Drlg. 2825	
12/29	3000 SD	
1945		
1/3	" "	
1/10	Drlg 3807	
1/17	Drlg 3807 SD	
1/26	3807' S.D.	
1/31	So	3572-3582
	Cong	3947
	Simp	3956
	Arb.	3963
	SO	3964-3968
	Stans.	3968-93
	TD 4100	
	5" @ 4046	
	47 shots 3956-3963 250 acid	
	2800' water squeeze off	
2/7	To perf	
2/14	Plug 3912 59 shots 3884-92	
	250 acid swb 10 oil a day Gravity	
	47-3	

OVER

1945

~~2/21~~

1200 acid swb 25 oil PH  
Plug 3800 23 shots 3629-33  
1000 oil 5 hrs 37<sup>0</sup> Gas

2/28

" " " " "

3/7

Pump 4 oil PH

3/14

500 acid pump 16 oil per hr 16 hrs

3/21

Lans 3551

Arb 3963

5" @ 4046 Perf. Lans 1700 acid  
TD 4100'

Pump 406 Pot.

Grav. 37.0

**COMPLETED**

Pool Name WildcatMap No. 66 Sec. 27 Twp. 10 R. 22 W.Well No. 1 FaulknerFred Koch CompanyFIRST REPORT Contractor

SW SE SE

## SECTION PLAT

         Ft. from N. Line330 Ft. from S. Line990 Ft. from E. Line         Ft. from W. Line


GrahamLocation         Rig up         

Drilling and Remarks:

s h

## RECORD

Cased          in.,          ft.Sand         Gas         Oil         Total Depth         

## PRODUCTION

1st 24 hrs. Nat.         1st 24 hrs. after shot         Gas          Cu. Ft.Dry Hole         Abandoned         

Date

DEC 6 1944 19S. J. LEWIS Scout



Pool Name Wildcat

Map No. 66 Sec. 27 Twp. 10 R. 22W

Well No. 1 Faulkner

Wood River etal Company

**COMPLETED** Contractor

SW SE SE

SECTION PLAT

			2

         Ft. from N. Line

330 Ft. from S. Line

990 Ft. from E. Line

         Ft. from W. Line

Graham County

Location                                 

Rig up                                 

Drilling and Remarks:

*Lane 3551*  
*Ac 83963*  
*5' 04046*  
*Perf Lane.*  
*1300 acid*  
*Pump 406 Prod.*  
*872 lbs.*

RECORD

Cased          in.,          ft.

Sand                                 

Gas                                 

Oil                                 

Total Depth 4100

PRODUCTION

1st 24 hrs: Nat.                         

1st 24 hrs. after shot                         

Gas                                  Cu. Ft.

Dry Hole                                 

Abandoned                                 

Date

MAR 21 1945 19         

S. J. LEWIS Scout