


Section 27 Township 10 Range 22-W

Well No. 1. Faulkner

Company Davis-Childs

Webster Pool

NORTH

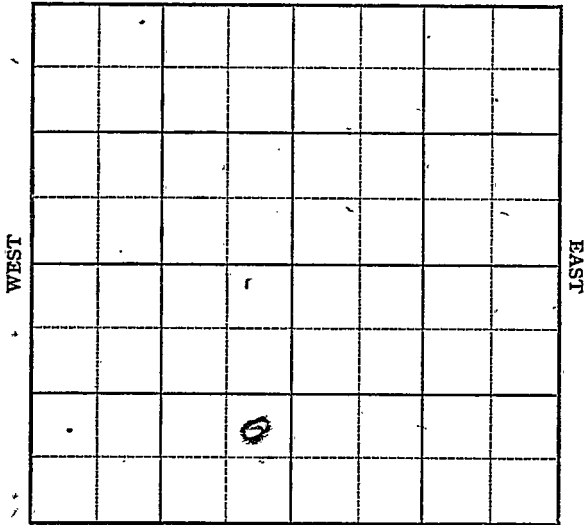

SOUTH

Sec. 27 Twp. 10 R. 22-W

Well No. # 1 Faulkner Farm

Davis-Childs Company


Webster Pool

_____ Ft. from N. Line

990 Ft. from S. Line

330 Ft. from E. Line

_____ Ft. from W. Line

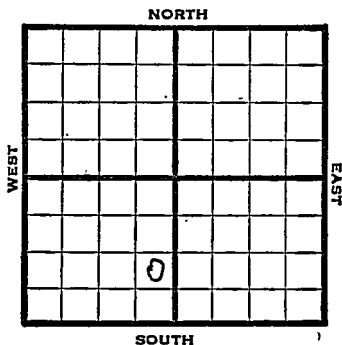

NE SE SW

1947 Elev. 2301' REPORT

7/2 Location
7/8 R U R
7-16 8" @ 256
Drlg. 3544
7/23 Lansing 3565'
T.D. 3668'
Abandoned

ABANDONED

Map No. _____ Sec. 27 Twp. 10 R. 22W

Well No. 1 Faulkner

Davis-Childs Company

FIRST REPORT

Contractor

NE SE SW

SECTION PLAT

_____ Ft. from N. Line

990 Ft. from S. Line

330 Ft. from E. Line

_____ Ft. from W. Line

	6		

Graham County

Location X

Rig up _____

Drilling and Remarks:

RECORD

Cased _____ in., _____ ft.

Sand _____

Gas _____

Oil _____

Total Depth _____

PRODUCTION

1st 24 hrs. Nat. _____

1st 24 hrs. after shot _____

Gas _____ Cu. Ft.

Dry Hole _____

Abandoned _____

Date

JUL 2 1947 19

S. J. LEWIS Scout

Map No. 66 Sec. 27 Twp. 10 R. 22W

Well No. 1 Faulkner

Davis Childs Company

ABANDONED

Contractor

NE SE SW

E. 2301

SECTION PLAT

Ft. from N. Line

990

Ft. from S. Line

330

Ft. from E. Line

Ft. from W. Line

Graham County

Location _____

Rig up _____

Drilling and Remarks:

Leas 8565

RECORD

Cased _____ in., _____ ft.

Sand _____

Gas _____

Oil _____

Total Depth 3668

PRODUCTION

1st 24 hrs. Nat. _____

1st 24 hrs. after shot _____

Gas _____ Cu. Ft.

Dry Hole _____

Abandoned _____

Date

JUL 23 1947 19

S. J. LEWIS

Scout