


Section 27 Township 10 Range 21W

Well No. #1 Noah

Company Kiowa Drlg.

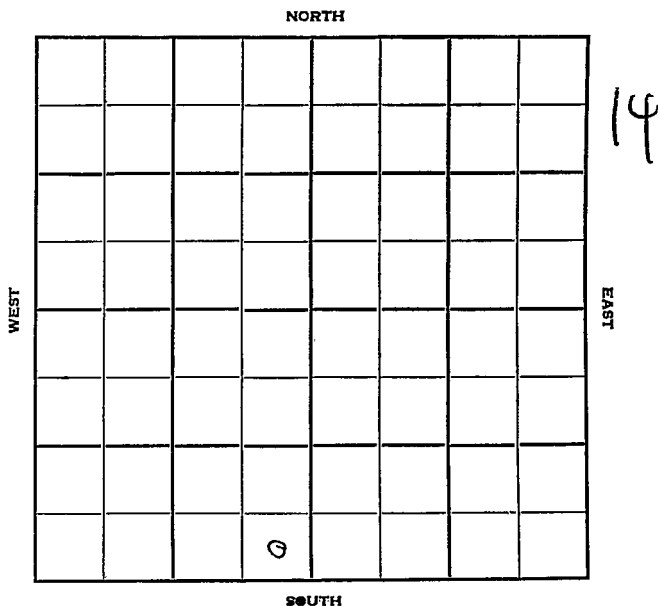

Graham

KANSAS

Sec. 27 Twp. 10 R. 21 W

Well No. # 1 Noah Farm

Kiowa Drlg. Company

Contractor


 Ft. from N. Line

330 Ft. from S. Line

330 Ft. from E. Line

 Ft. from W. Line

SE SE SW

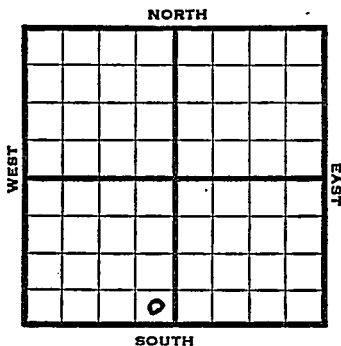

1952

Elev. -

REPORT

8/6

Drilling

8/13

Abandoned location

ABANDONED

County Graham State Kansas

Sec. 27 (Blk. Twp.) 10 (Sur. Rge.) 21W Map No.

Operator Kiowa Drlg.

Well No. **1** Farm **Noah**

Elev.	Location	SE	SE	SW
-------	----------	----	----	----

FIRST REPORT

330 Ft. From S Line SW

330 Ft. From E Line Quarter

1st. Report AUG 6 1952

Completion

Remarks

Spudding Date

Drlg. Data

Drlg.

J. G. McGEHEE

J. G. McGEHEE