


DX 78-1

Section 28 Township 10 Range 23 W

Well No. #3 Nemechek

Company Cities Service

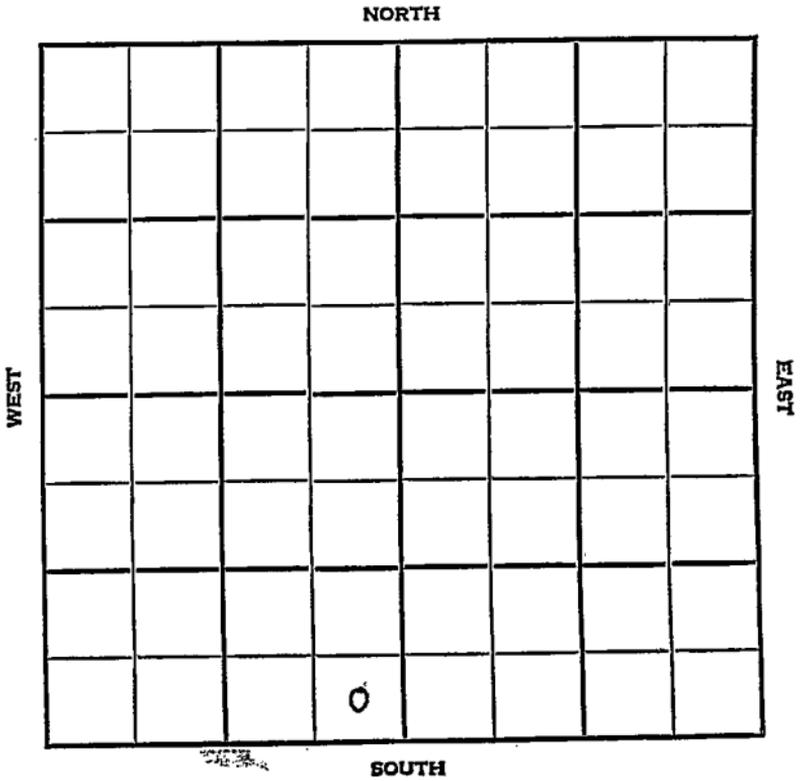

Graham

KANSAS

SEC.	TWP.	R.
28	10	23W

WELL NO.

#3 Nemechek

FARM

COMPANY

Cities Service

CONTRACTOR

L & J


Happy

_____ Ft. from N. Line

_____ Ft. from S. Line

_____ Ft. from E. Line

_____ Ft. from W. Line

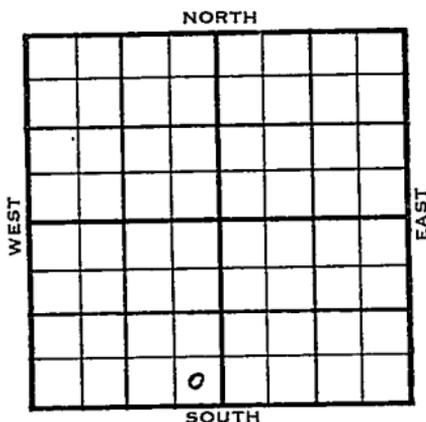

SE SE SW

1955

ELEVATION

2370

REPORT

8/24

Comm 8-20-55

8" @ 240/175

Drlg 2500

10/5

Comm 8-20-55

8" @ 240/175

H 3586

Dodge 3610

L 3621

TD 3855

DST 3611-35 open 1/2 hr Rec 2' mud

O# DST 3778-98 open 1 hr Rec 1315'

gas 120' hocm 60' geo 470/30" DST

3802-20 open 1/2 hr. Rec 5' mud

40/30" 5 1/2" @ 3855 CO to 3851

45/3777-88 B/20 go 6 gw 16 h₅ 1000

A P/396 bo 24 hr

Comp 243 bopd

COMPLETED

County Graham Elev. 2370
 Sec. 28 Twp. 10 Rge. 23W
 Company Cities Service
 Farm Name Nemechek No. 3

TOPS	DEPTH	LOG	DATUM
Anh.			
Tp.			
H.			
Tr.			
Dg.			
BL.			
L.			
K.C.			
B.K.C.			
Ce.			
C.			
M.			
M.			
K.			
Mz.			
Mq.			
V.			
S.			
S.			
A.			
R.			
PE.			
G.			
T.D.			

Loc. in Sec. SE SE SW
 Geol. _____
 Contr. L & J
 Pool Henry
 AUG 24 '55
FIRST REPORT
 6

Date Comm. 8-20-55
8 @ 240/175 - drlg. 2500

[Handwritten scribbles and marks]

Co.
Lsc.
No.
Sec.
T.
R.

County Graham Elev. 2370
 Sec. 28 Twp. 10 Rge. 23W
 Company Cities Service
 Farm Name Nemechek No. 3

Co.

TOPS	DEPTH	LOG	DATUM
Anh.			
Tp.			
H.	<u>3586</u>		<u>1216</u>
Tr. <u>Dodge</u>	<u>3610</u>		<u>1240</u>
Dg.			
Bl.			
L.	<u>3621</u>		<u>1251</u>
K.C.			
B.K.C.			
Ce.			
C.			
M.			
M.			
K.			
Mz.			
Mo.			
V.			
S.			
S.			
A.			
R.			
PE.			
G.			
T.D.	<u>3855</u>		

Loc. in Sec. SE SE SW

Geol. _____
 Contr. I & J

Pool Happy

COMPLETE		

Use.

No.

Sec.

T.

R.

Date Comm. 8-20-55 OCT 5 1955

8" @ 240/175 DST 3611-35 open 1/2 hr.

Rec. 2' mud Off DST 3778-98 open 1 hr.

Rec. 1315' gas 120' hocm 60' gco

170/30" DST 3802-20 open 1/2 hr.

Rec. 5' mud 110/30" 5 1/2" @ 3855

GO to 3851 115/ 3777-88 B/ 20 go 6 gw

16 hr. 1000 A P/ 396 bo 2 1/2 hr.

Comp. 213 bopd