


DX 78-1 Graham

KANSAS

Section 28 Township 10 Range 23W

Well No. #4 Nemecheck

Company Lario Oil & Gas

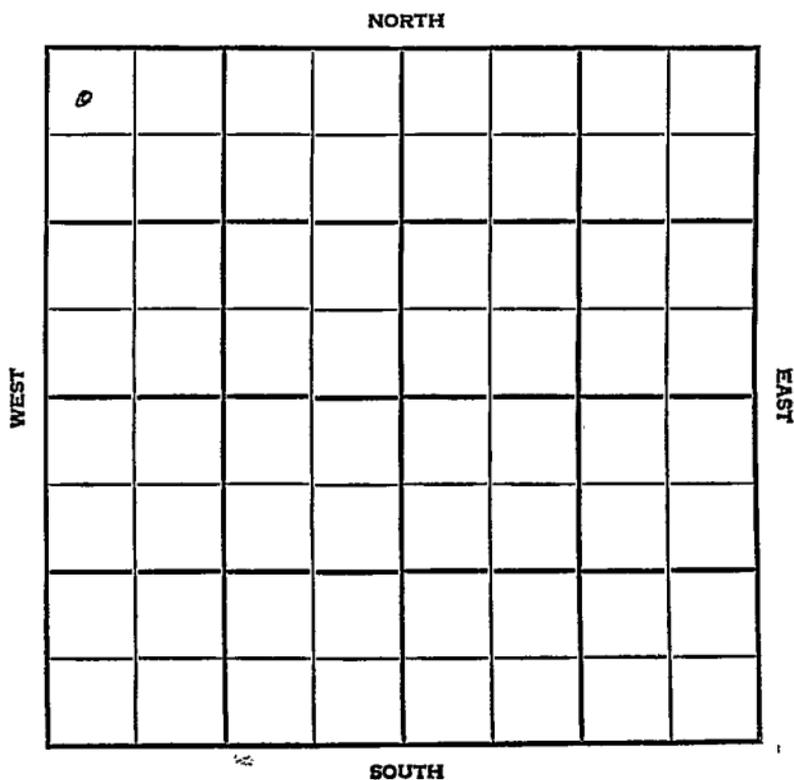

HOT FILE

Grham KANSAS

SEC. 28 10 23W

WELL NO. 4 Nemecheck FARM

COMPANY

Lario Oil & Gas

CONTRACTOR Transit

Happy Pool

330 Ft. from N. Line

Ft. from S. Line

Ft. from E. Line

330 Ft. from W. Line

NORTH

WEST EAST

SOUTH

NW NW NW

1954	ELEVATION 2401'	REPORT
------	--------------------	--------

11/17
12/15

Location

Spud 11-19-54

Oil Well

TD 3915'

8-5/8" @ 244'

Lans 3658'

DST 3790'-3807' opn 1 hr, rec 60' swm
630#

DST 3810'-35' opn 1 hr, gas in 20 min
rec 1455' gassy oil, 625#

DST 3838'-55' opn 1 hr, rec 30' ocm,
105#

TD 3915'

5" @ 3913'

CO 20/ 3825-30 FU 2800' oil 3 hr.
S/ 16 boph 6 hr.

Comp 417 bopd.

COMPLETED

County Graham State Kansas

Sec. 28 (Blk. 10) (Sur. 23W) (Twp.) Map No.

Operator Lario Oil & Gas

Well No. 4 Farm Nemecheck

Elev. 2401 Location NW NW NW

0					

330 Ft. From N Line NW
330 Ft. From W Line Quarter

1st. Report

Completion DEC 15 1954

Remarks Happy Pool

Transit - Contr,

Spudding Date 11-19-54

Drig. Data Oil well TD 3915

8 5/8" @ 244 Lans. 3658 DST 3790-3807

open 1 hr. Rec. 60' swm 630#

DST 3810-35 open 1 hr. gas in 20 min.

Rec. 1455' gassy oil 625# DST 3838-55

open 1 hr. Rec. 30' ocm 105# TD 3915

5" @ 3913 CO 20/ 3825-30 FU 2800' oil

3 hr. S/ 16 boph 6 hr.

Comp. 417 bopd

FABEN GILSTRAP