


DX 78-1 Graham

KANSAS

Section 28 Township 10 Range 23W

Well No. #1 Steve Namecheck

Company Magnolia Pet.

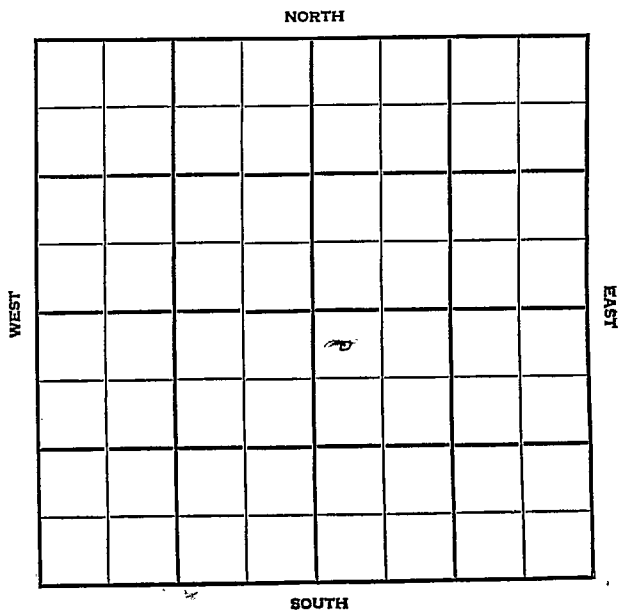

Graham KANSAS

SEC.	TWP.	R.
28	10	23W

WELL NO. 1 Steve Nemecheck FARM

COMPANY Magnolia Petr.

CONTRACTOR Transit


Happy Pool

330 Ft. from N. Line

\_\_\_\_\_ Ft. from S. Line

\_\_\_\_\_ Ft. from E. Line

330 Ft. from W. Line

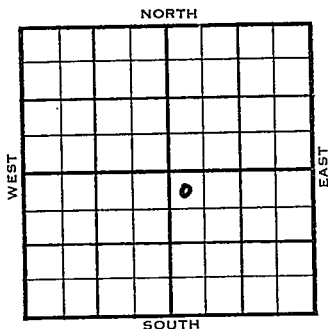

NW NW SE

	ELEVATION	REPORT
1954	2369'	

11/17 Spud 11-17-54  
 9" @ 411'  
 Drlg. 2660'

12/15 Spud 11-17-54  
 Oil Well  
 TD 4143'  
 9" @ 411'  
 Heeb 3583', Tor 3604' Lans 3618'  
 DST 3606'-30' opn 1 hr, rec 1355'  
 gcsw, 1220#  
 DST 3656'-80' opn 1 hr, rec 2250'  
 gcsw, 1100#  
 DST 3771'-95' opn 1/2 hr, gas in 8 min  
 F/ oil in 28 min 1290#  
 F/ 6 bo 6 min Rec 655' oil Cong 4060'  
 Simp 4108' Arb. 4116'  
 TD 4143'  
 5" @ 3935' CO to 3892 20/ 3835-  
 40 B/ 2 1/2 gwph 6 hr. 1000 A S/ 12  
 boph 9 hr.  
 PB 3830'  
 16/ 3816-22 S/ 17 boph 6 hr.  
 Comp 308 bopd. **COMPLETED**



