


Section 28 Township 10 Range 23W

Well No. 4 Fee "B"

Company Wickizer

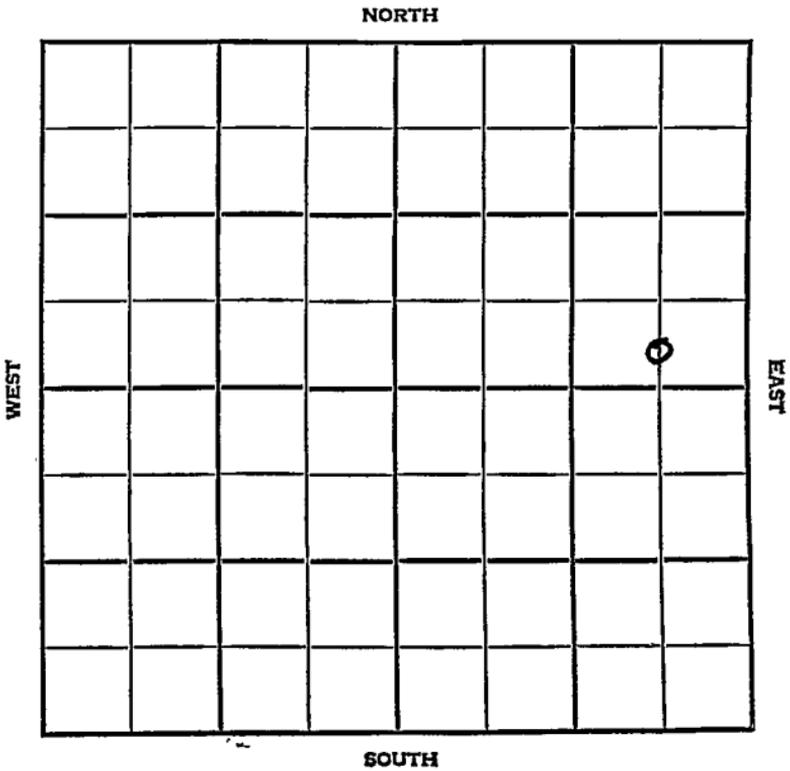

Graham KANSAS

SEC.	TWP.	R.
28	10	23W

WELL NO. 4 Fee "B" FARM

COMPANY Wickizer

CONTRACTOR Co. Tools

Happy Pool


_____ Ft. from N. Line

330 _____ Ft. from S. Line

660 _____ Ft. from E. Line

_____ Ft. from W. Line

C S/2 SE NE

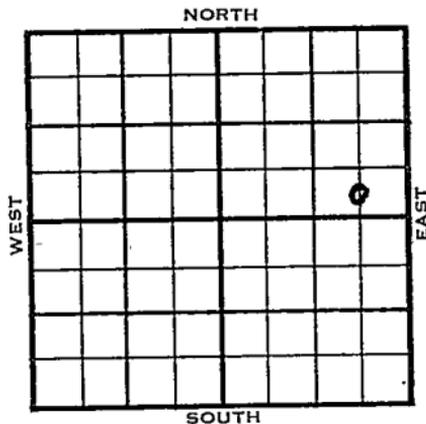

1955	ELEVATION 2375'	REPORT
------	--------------------	--------

3/2 Spud 2-22-55
8" @ 355'
Drlg. 3145'

4/20 Spud 2-22-55
Oil Well
TD 3890'
8" @ 355'
Top 3374' Heeb. 3601' Tor. 3620'
Lans. 3633'
DST 3647'-658', opn 1/2 hr, rec 10' Mud O#
DST 3663'-85' opn 1 hr, rec 1560' s.w.
975#
DST 3824'-41' opn 1 hr, rec 110' gocm
355#
TD 3890'
5" @ 3890'
24/ 3846-52 3000 A
Comp 240 bopd. 5% Wtr

COMPLETED

County Graham State Kansas

Sec. 28 (Blk.) 10 (Sur.) 23W Map No.

Operator Wickizer

Well No. 4 Farm Fee "B"

Elev. _____ Location G.S. $\frac{1}{2}$ SE NE

330 Ft. From S Line NE

660 Ft. From E Line Quarter

1st. Report MAR 2 1955

Completion _____

Remarks _____

Co. tools

Spudding Date 2-22-55

Drlg. Data Happy Pool

8" @ 355 drlg. 3145

FABEN GILSTRAP

