

Graham KANSAS


DX 78-1

Section 28 Township 10 Range 23W

Well No. 2 Nemoehok

Company Lario

NORTH

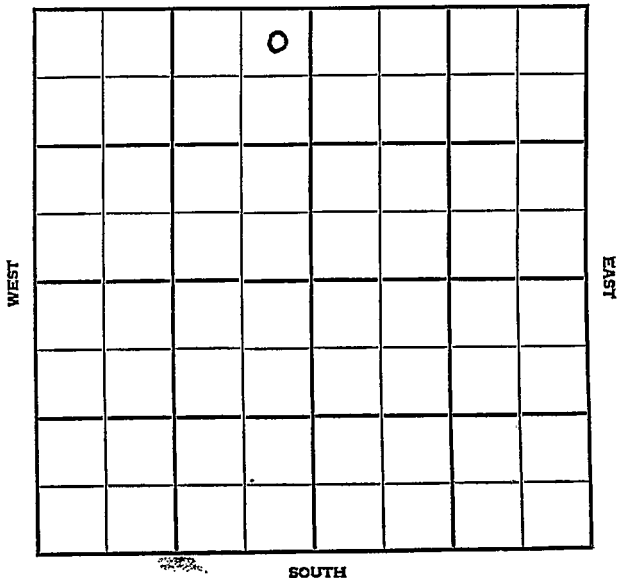

Graham KANSAS

SEC. 28	TWP. 10	R. 23W
WELL NO. 2 Nemechek		
FARM Lario		
CONTRACTOR Transit		


SE Happy Pool

330 _____ Ft. from N. Line

_____ Ft. from S. Line

330 _____ Ft. from E. Line

_____ Ft. from W. Line

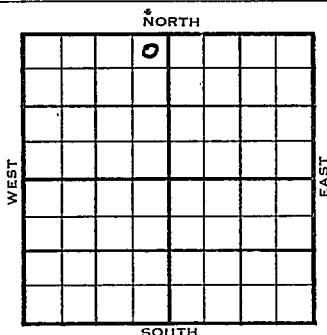

NE NE NW

1954

ELEVATION

2389'

REPORT

7/28

M I R

8/11

Heeb 3610', Tor 3630', Lans 3647'
 DST 3780'-95', 1 hr., 185' gas, 85'
 O&GCM, 300#
 DST 3798'-3818', 1 hr., 770' oil, 40'
 gas, 700#
 DST 3816-35', 1 hr., 2' mud, 0#
 DST 3836-56', 1 hr., 60' ho&gcm, 125#
 TD 3910'
 5" @ 3910'

8/25

Spud 7-28-54 - Oil Well

TD 3910'

8" @ 233'

Heeb 3610', Tor 3630', Lans 3647'

DST 3780-95', opn 1 hr., rec. 185'
 gas, 85' o & gcm, 300#

DST 3798-3818', opn 1 hr., rec. 770'
 oil, 40' gas, 700#

DST 3816-35, opn 1 hr., rec. 2' mud,
 0#

DST 3836-56, opn 1 hr., rec. 60' ho &
 gcm, 125#

TD 3910'

5" @ 3910

GO to 3820

(Information Brought Forward)

1954

8/25

32/3807-15, S/5 boph 4 hrs., 1000A

S/4 $\frac{1}{4}$ boph

P/170 bo 20 hrs.

C omp. 132 bopd

COMPLETED

County **Graham** State **Kansas**
 Sec. **28** (Blk. Twp.) **10** (Sur. Rge.) **23W** Map No.
 Operator **Lario**
 Well No. **2** Farm **Nemechek**
 Elev. Location **NE NE NW**

			0				

FIRST REPORT

530 Ft. From **N** Line **NW**
330 Ft. From **E** Line Quarter

Ist. Report **JUL 28 1954**

Completion

Remarks

Transit - Contr.

Spudding Date

Drlg. Data

SE Happy Pool

M I R

J. G. McGEHEE

FABEN GILSTRAF