

Graham

KANSAS

SECTION 28 TOWNSHIP 10 RANGE 23 WWELL NO. #1 NemechekCOMPANY Cities Service

NORTH

WEST

EAST

SOUTH

Graham

KANSAS

SEC.	TWP.	R.
28	10	23W

WELL NO.

#4 Nemechek

FARM

COMPANY

Cities Service

CONTRACTOR

Diebolt


_____ Ft. from N. Line

_____ Ft. from S. Line

_____ Ft. from E. Line

_____ Ft. from W. Line

SW NE SW

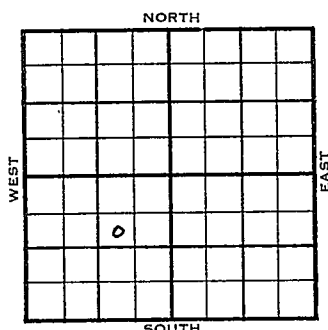

1955

ELEVATION

2372'

REPORT

11/2

Loc

12-28

Comm. 11-9-55

8 5/8" @ 245/175

DST 3798-3807 op 1/2 hr. rec. 12' mud, O#

DST 3773-3807 op 1 hr. rec. 273' mud & SW, 1020/30"

DST 3804-25 op 1 hr. rec. 272' o&gcm 180' gco 465/30"

5 1/2" @ 3875/175

CO to 3857, 50/ 3808-21, FU 687' oil, 15 hrs., 1000 A

P/ 116 B0, 4 BW 13 hrs.

Comp. 251 BOPD

H. 3603

Dodge 3628

L. 3640

TD 3875'

COMPLETED

County

~~Graham~~

Elev.

Sec.

28

Twp.

10

Rge.

23W

Company

Cities Service

Farm Name

Nemerchek

No.

1

TOPS

DEPTH

LOG

DATUM

Loc. in Sec.

Anh.

SW NE SW

Tp.

H.

Tr.

Dg.

Bl.

L.

K.C.

B.K.C.

Ce.

C.

M.

M.

K.

Mz.

Mq.

V.

S.

S.

A.

R.

PE.

G.

T.D.

Geol.

Contr.

HAPPY

FIRST REPORT

NOV 2 '55

Date Comm.

Location

Co.

Lse.

No.

Sec.

T.

R.

County Graham Elev. 2372
 Sec. 28 Twp. 10 Rge. 23W
 Company Cities Service
 Farm Name Nemechek No. 4

TOPS	DEPTH	LOG	DATUM	Loc. in Sec.
Anh.				SW NE SW
Tp.				
H.	<u>3603</u>		<u>1231</u>	
Tr. <u>Dodge</u>	<u>3628</u>		<u>1256</u>	
Dg.				
Bl.				
L.	<u>3640</u>		<u>1268</u>	
K.C.				Geol.
B.K.C.				Contr.
Ce.				7/APPY
C.				Pool
M.				<u>Diebolt</u>
M.				
K.				
Mz.				
Me.				
V.				
S.				
S.				
A.				
R.				
PE.				
G.				
T.D.	<u>3875</u>			

Date Comm. 11-9-55 DEC 2 8 1955

8 5/8" @ 245/175 DST 3798-3807

open 1/2 hr. rec. 12' mud O#

DST 3773-3807 open 1 hr. rec. 273'

mud & SW 1020/30" DST 3804-25

open 1 hr. rec. 272' o & gcm 180' geo

165/30" 5 1/2" @ 3875/175 GO to 3857

50/ 3808-21 FU 687' oil 15 hr. 1000 A

P/ 116 bo 4 bw 13 hr.

Comp. 251 bopd