


Graham

KANSAS

SECTION 28 TOWNSHIP 10 RANGE 23W

WELL NO. #5 Nemechek

COMPANY C.S.O.

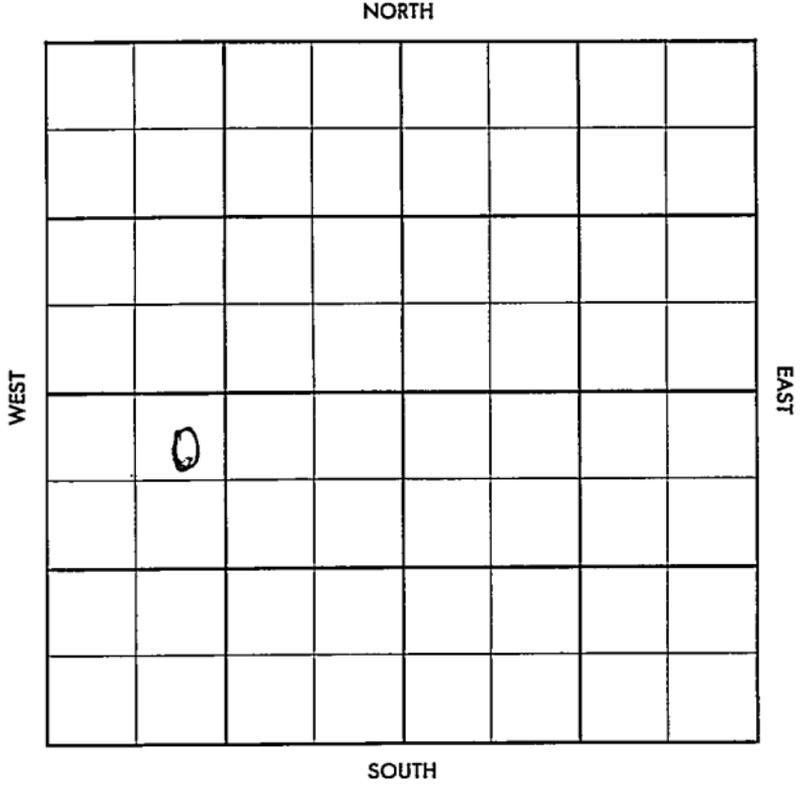

County Graham Elev. _____
 Sec. 28 Twp. 10 Rge. 23W
 Company C. S. O.
 Farm Name Nemechek No. 5

TOPS	DEPTH	LOG	DATUM
Anh.			
Tp.			
H.			
Tr.			
Dg.			
Bl.			
L.			
K.C.			
B.K.C.			
Ce.			
C.			
M.			
M.			
K.			
Mz.			
Me.			
V.			
S.			
S.			
A.			
R.			
PE.			
G.			
T.D.			

Loc. in Sec. NE NW SW
 Geol. _____
 Contr. Lehmann & Johnson
 Tools _____
 Pool 1
HAPPY
 REPORT
 DEC 28 '35

Date Comm. _____
 Location _____

57

Co.

Log

No.

Sec.

T.

R.

County Graham Elev. 2379 DF
 Sec. 28 Twp. 10 Rge. 23W
 Company C. S. O.
 Farm Name Nenechek No. 5

TOPS	DEPTH	LOG	DATUM	Loc. in Sec.
Anh.				NE N1 St.
Tp.	3392	3406		
H.	3411	3425		
Tr. <u>Dodge</u>	3637	3651		
Dg.				
Bl.				
L.	3651	3665		
K.C.				Geol.
B.K.C.				Contr.
Ce.				Lohmann & Johnson
C.				Woods
M.				Pool
M.				<u>HAPPY</u>
K.				
Mz.				
Mo.				
V.				
S.				
S.				
A.				COMPLETE
R.				
PE.				
G.				
TD	<u>3910</u>	<u>3740</u>		JAN 23 '57

Date Comm.

Location JAN 2 '57 12-30-56 8 5/8
 240/175 @ 2775
 JAN 9 '57 X DST 3865⁵⁴ 40 1hr 175'
 0.5 GCM + 270' oil BHP 525/20"
 DST 3853-85 1hr 135' M5W
 BHP 885/30" R29 5 1/2
 JAN 15 '57 5 1/2 @ 3909/200 co 3898
 57/3836-50 1050' oil + 30' wt. 10 hrs
 TO Acid JAN 15 '57 1 1/2 Ph P. 300 BHP
 no/wt.

Co.
No.
Sec.
T.
R.