


Section 28 Township 10 S Range 23 W

Well No. # 5 Nemecheck

Company Larion O & G

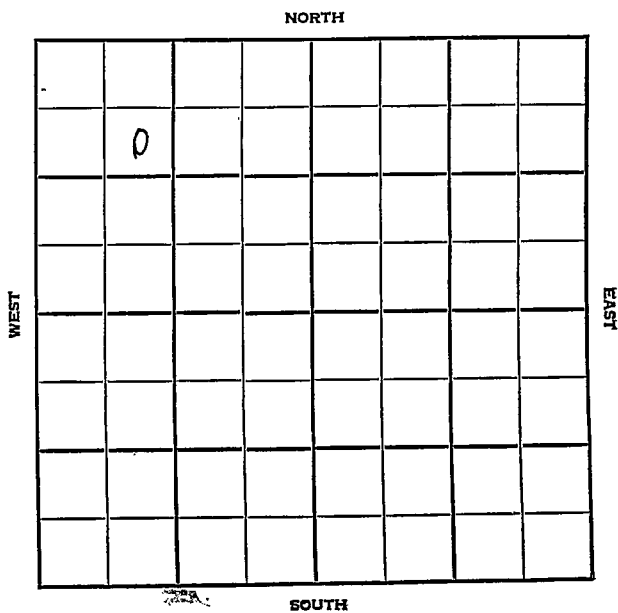

Grham KANSAS

SEC.	TWP.	R.
28	10S	23W


WELL NO. **5 Nemecheck** FARM

COMPANY **Lario O&G**

CONTRACTOR **Transit Tools**

Happy

990 \_\_\_\_\_ Ft. from N. Line  
 \_\_\_\_\_ Ft. from S. Line  
 \_\_\_\_\_ Ft. from E. Line  
 990 \_\_\_\_\_ Ft. from W. Line

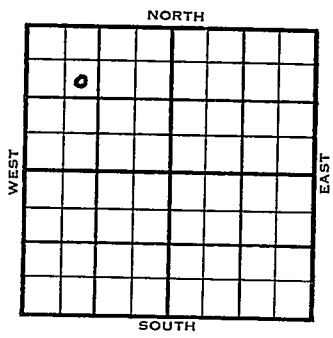

SE NW NW

1954	ELEVATION 2400'	REPORT
------	--------------------	--------

12/8 Spud 12-3-54  
 8" @ 245' w/165 sks  
 rlg. 2767'

1955  
 1/19 Spud 12-3-54  
 Oil Well  
 TD 3915'  
 8" @ 245'  
 Lans 3653'  
 DST 3785'-3810' opn 1/2 hr, rec 34' Mud  
 620#  
 DST 3806'-30' opn 1 hr, rec 95' ho &  
 gcm 130#  
 DST 3832'-52' opn 1 hr, rec 260' gas,  
 65' o & gcm 110#  
 DST 3852'-3915' opn 1 hr, rec 40' socm  
 90' ho & gcm 50% oil, 279 Muddy oil  
 535' gassy oil 110' s w. 1005  
 TD 3915'  
 5" @ 3914'  
 CO 20/ 2854-59 S/ 1 boph 2000 A  
 S/ 8 boph 8 hr.  
 Comp 227 bopd. **COMPLETED**


Sec. 28 (Blk. Twp.) 10S (Sur. Rge.) 23W Map No.

Operator Lario O & G

Well No. 5 Farm Nemecheck

Elev. Location SE NW NW


990 Ft. From N Line

990 Ft. From W Line NW Quarter

1st. Report DEC 8 1954

Completion

Remarks Transit tools

Spudding Date 12-3-54

Drlg. Data Happy

8" @ 215 w/165 Drlg 2767

County Graham State Kansas

Sec. 28 (Blk.) 10 (Sur.) 23W Map No.

Operator Lario

Well No. 5 Farm Nemecheck

Elev. 2400 Location SE NW NW


990 Ft. From N Line NW c

990 Ft. From W Line Quarter

1st. Report

Completion JAN 1 9 1955

Remarks Happy Pool

Transit - Contr.

Spudding Date 12-3-54

Drlg. Data Oil well TD 3915

8" @ 245 Lans. 3653 DST 3785-3810

open 1/2 hr. Rec. 34' mud 620#

DST 3806-30 open 1 hr. Rec. 95' ho &

gcm 130# DST 3832-52 open 1 hr.

Rec. 260' gas 65' o & gcm 110#

DST 3852-3915 open 1 hr. Rec. 40' socm

90' ho & gcm 50% oil 279' muddy oil

535' gassy oil 110' sw 1005 TD 3915

5" @ 3914 CO 20/ 3854-59

S/ 1 boph 2000 A S/ 8 boph 8 hr.

Comp. 227 bopd

FABEN GILSTRAP