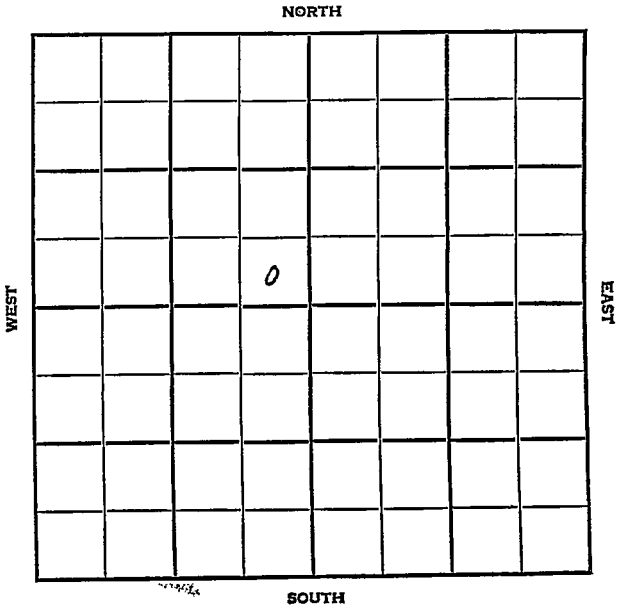


Section 28 Township 10 Range 23WWell No. #6 NemechekCompany Lario

Graham

Kansas

SEC.	TWP.	R.
28	10	23 W

WELL NO.

6 Nemechek

FARM

COMPANY

Lario

CONTRACTOR

Happy Pool


Ft. from N. Line

330 Ft. from S. Line

330 Ft. from E. Line

Ft. from W. Line

SE SE NW

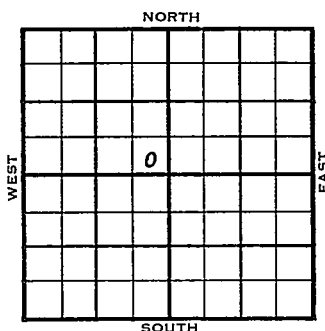

1954

ELEVATION

2371'

REPORT

12/15

Spud 12-14-54

1955

1/26

Spud 12-14-54 - Oil Well

TD 3880'

13-3/8" @ 345'

Heeb. 3595', Tor. 3614', Lans 3630'

DST 3789-3807', opn 1 hr., rec. 15'

mud, 0#

B KC 3871'

DST 3827-80', opn 1 hr., rec. 125'

socm, 795#

TD 3880'

5" @ 3879'

CO

28/3838-45', 250A

5/1 1/2 to 2 goph 2500A


SP, 48/3812-24, 2500A

2 bph some wtr.

omp. 35 bopd 65% wtr.

COMPLETED

FABEN GILSTRAP

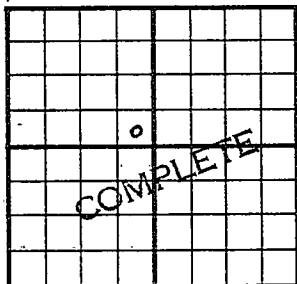County Graham State KansasSec. 28 (Blk. Twp.) 10 (Sur. Rge.) 2 3W Map No.Operator LarioWell No. 6 Farm NemechekElev. 2371 Location SE SE NW330Ft. From S Line NW330Ft. From E Line Quarter

1st. Report

Completion JAN 2 6 1955Remarks Happy PoolSpudding Date 12-14-54Drlg. Data Oil well TD 388013 3/8" @ 345 Heeb. 3595 Tor. 3614Lans. 3630 DST 3789-3807 open 1 hr.Rec. 15' mud O# B KC 3871 DST 3827-80open 1 hr. Rec. 125' socm 795#TD 3880 5" @ 3879 CO 28/ 3838-45250 A S/ 1 1/2 to 2 goph 2500 ASP 48/ 3812-24 2500 A 2 bfphsome wtr. Comp. 35 bopd 65% wtr.

FABEN GILSTRAP