


DX 78-1

Company Wickizer

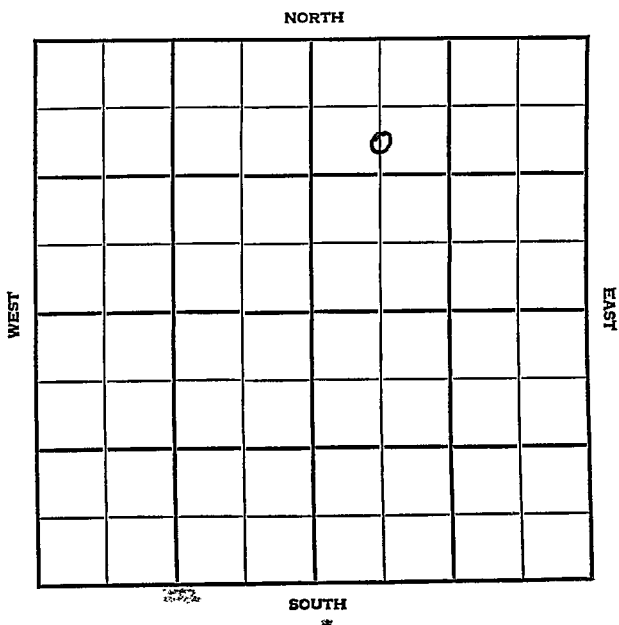

Graham KANSAS


SEC.	28	TWP.	10	R.	23W
WELL NO.					
3 Wickizer					
COMPANY					FARM
Wickizer					
CONTRACTOR					
Co. tools					
Happy Pool					

990 _____ Ft. from N. Line

_____ Ft. from S. Line

_____ Ft. from E. Line

660 _____ Ft. from W. Line

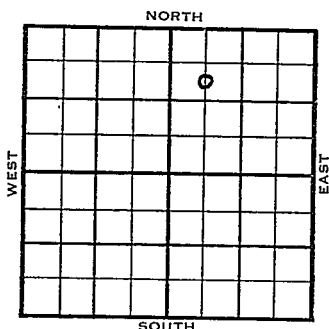

C S $\frac{1}{2}$ NW NE

1954	ELEVATION	REPORT
	2381	
7/28	Spd 7-22-54	
	8" @ 210	
	Drlg. 720	
11/23	Spud 7-22-54	
	Oil Well	
	TD 3875'	
	8" @ 210'	
	Heeb 3610', KC 3643'	
	DST 3612'-55' opn $\frac{1}{2}$ hr, rec 10' Mud	
	0#	
	DST 3780'-88' opn 1 hr, rec 110'	
	muddy wtr. 1125#	
	DST 3802'-35' opn 1 hr, rec 360' gas,	
	40' o & gcm, 300#	
	DST 3840'-50' opn $\frac{1}{2}$ hr, rec 15' Mud	
	0#	
	DST 3850'-75' opn 1 hr, rec 105' Mud	
	300#	
	TD 3875'	
	5" @ 3869'	
	CO 80/ 3822-34 3000 A SO Wtr.	
	Perf 3803-07 SP 3794	
	Perf 3781-85 3646-50 wtr. VSSO	
	CO 6/ 3841-43 30/ 3826-31 1500 A	
	S/ 3 boph VSSW	
	Comp 370 bopd.	
		COMPLETED

J. G. McGEHEE

FABEN G' STRAD